


RIVER PROJECT
STATE HWY PROJECT
GREENWAY PHOTOS
APRIL, 1987

WORK
COPY

RESERVOIR LOCATED
FROM SE CORNER
SECTION 23

1730 FT NORTH
1750 FT WEST

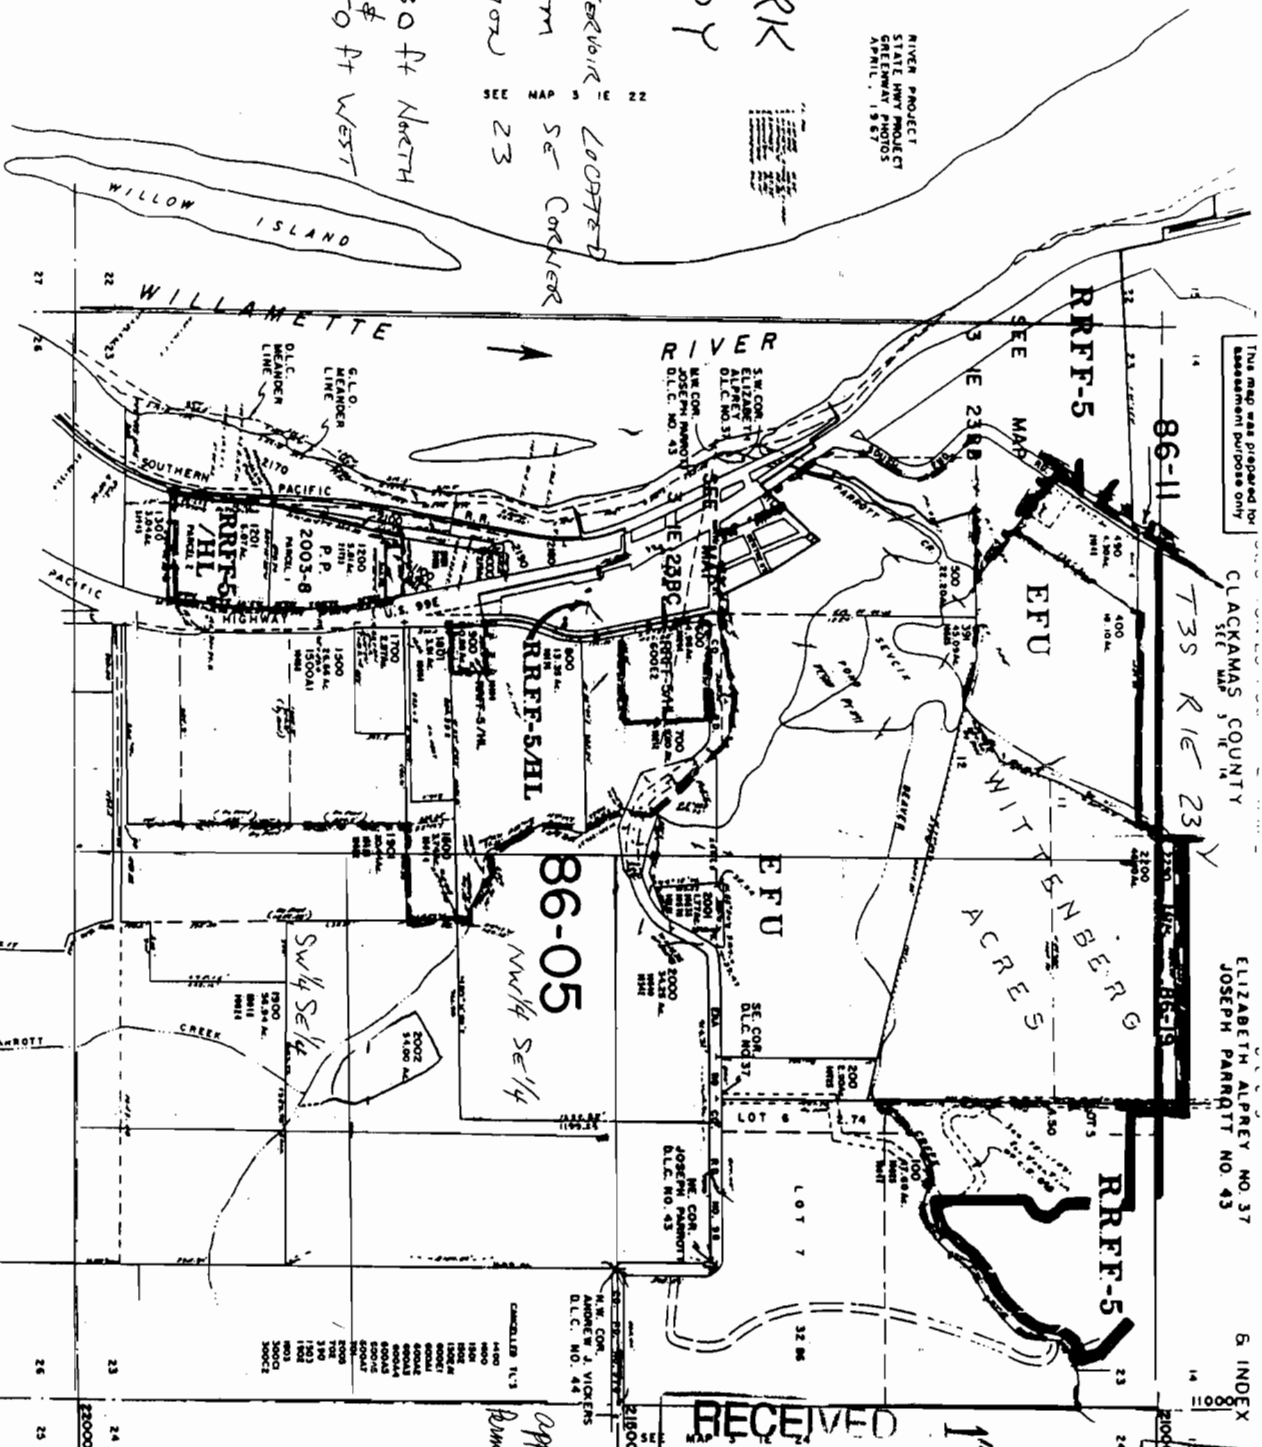

This map was prepared for
assessment purposes only

CLACKAMAS COUNTY
SECTION 23

ELIZABETH ALPREY NO. 37

6 INDEX

RECEIVED
APR 14 2005
WATER RESOURCES DEPT
SALEM, OREGON

RECEIVED
NOV 15 2004
WATER RESOURCES DEPT
SALEM, OREGON

1" = 600'
APPROX
SCALE

APP R-86132
R-14134


