


CLAIM OF BENEFICIAL USE MAP

UNDER APPLICATION R-85131; PERMIT R-13376

NE1/4 NE1/4 SEC 31 T 22S R 42E W.M.

U.S.G.S. QUAD - HURLEY FLAT, OREG. - 7 1/2'

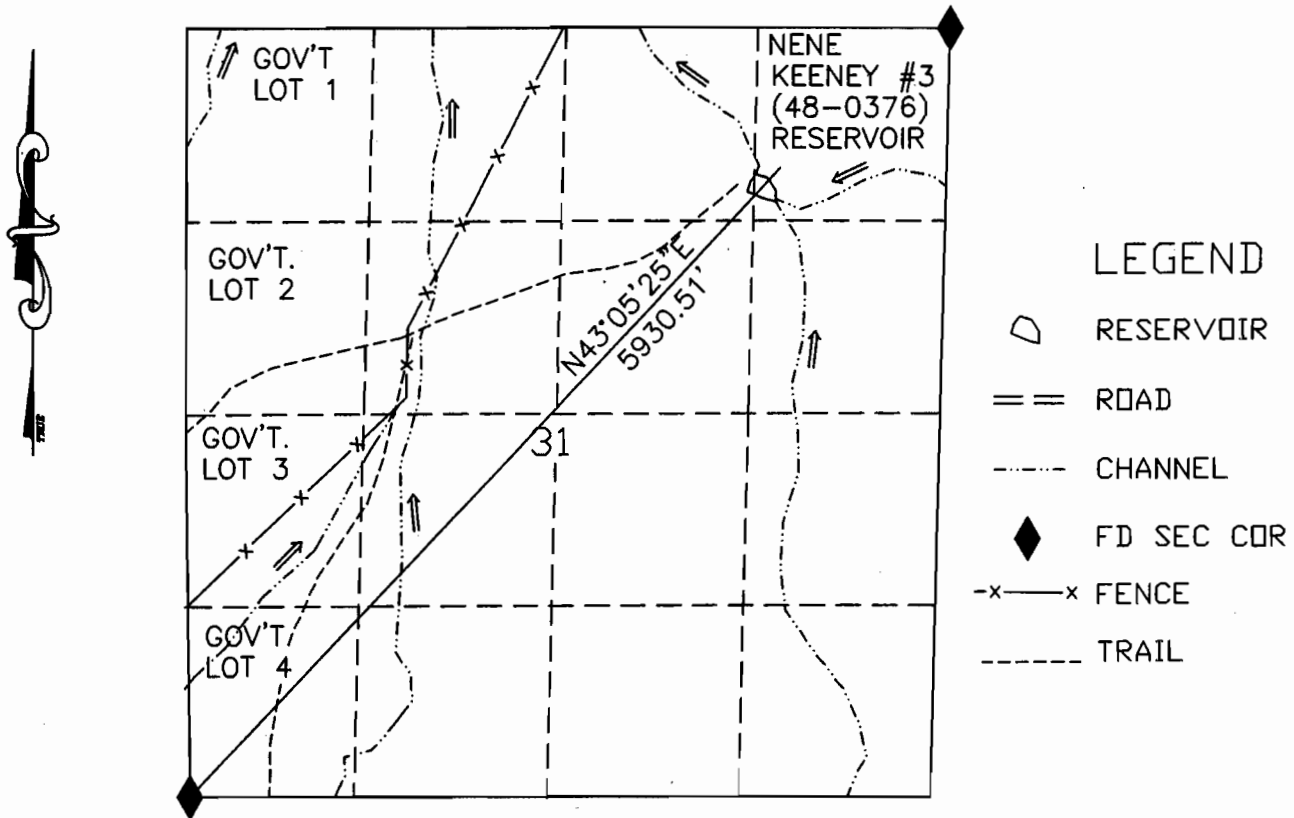


RECEIVED

JAN 06 2006

KEENEY CREEK #3 (48-0377) RESERVOIR

WATER RESOURCES DEPT
SALEM, OREGON

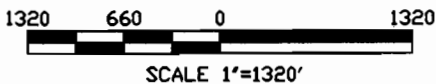

I, Charles E. Joy, Administrative Officer, Vale BLM agree to the findings of the CWRE and do submit this site report and map as my Claim of Beneficial Use of the water as provided under the terms and conditions of my Permit R-13376

Cathy Erblichbach (acting)



THIS MAP IS FOR THE PURPOSE OF LOCATING A WATER RIGHT AND IS NOT INTENDED TO PROVIDE LEGAL DIMENSIONS FOR LOCATION OF PROPERTY BOUNDARIES.

ACAD2005
DWG FILE: KEENEY3-BENE

UNITED STATES DEPARTMENT OF THE INTERIOR BUREAU OF LAND MANAGEMENT DIVISION OF OPERATIONS VALE DISTRICT	
KEENEY CREEK #3 (48-0377) RESERVOIR	
DESIGNED:	
REVIEWED:	
APPROVED:	<i>Cathy Erblichbach (acting)</i> ADMINISTRATIVE OPERATIONS AND FIELD SERVICES
DRAWN: CG	SCALE: 1"=1320'
DATE: 12/14/05	SHEET 1 OF 1
DRAWING NO. OR-03-9172.45-1243	