


CLAIM OF BENEFICIAL USE MAP

UNDER APPLICATION R-85142 ; PERMIT R-13385


NE1/4 SE1/4 SEC 23 T 36S R 43E W.M.

U.S.G.S. QUAD - BATTLE CREEK RANCH, OREG. - 7 1/2'

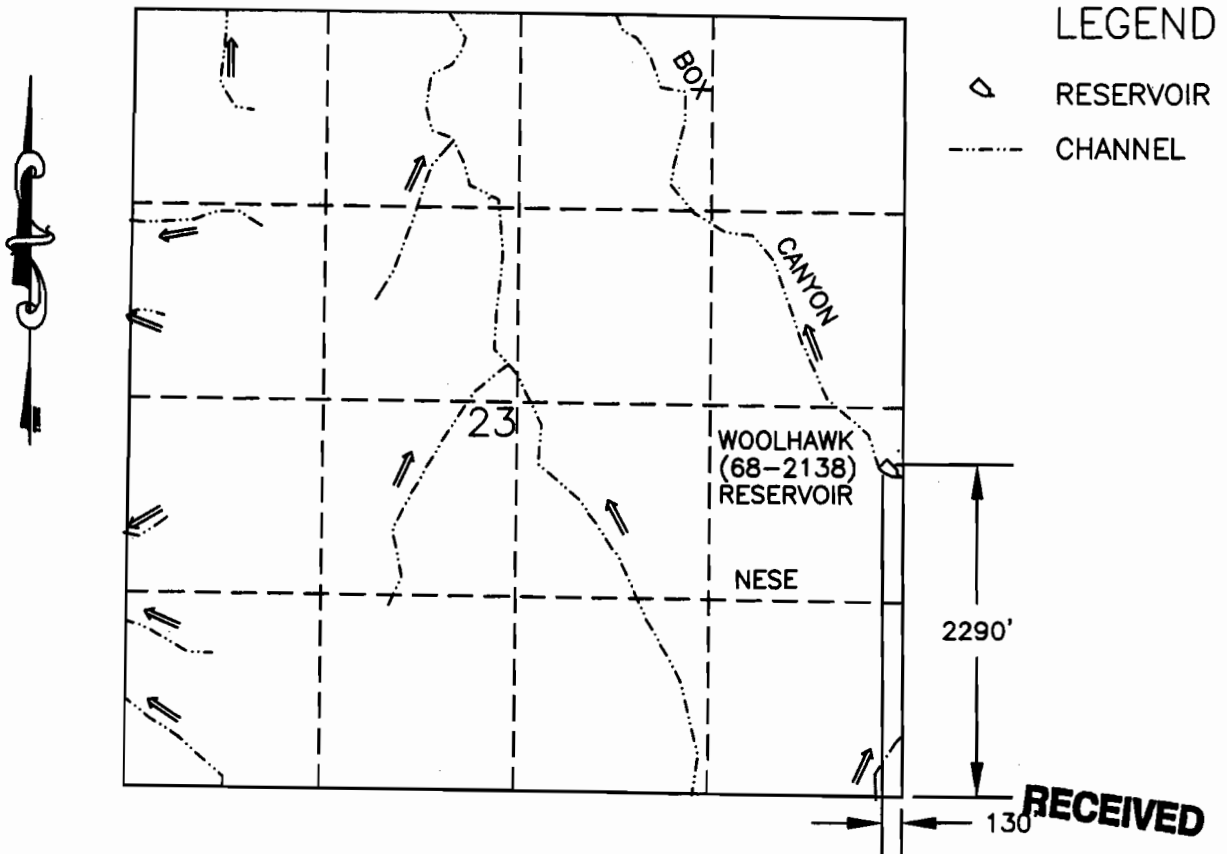

WOOLHAWK (68-2138) RESERVOIR

RECEIVED
JAN 06 2006
WATER RESOURCES DEPT
SALEM, OREGON

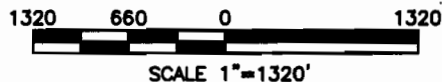

I, Charles E. Joy, Administrative Officer, Vale BLM agree to the findings of the CWRE and do submit this site report and map as my Claim of Beneficial Use of the water as provided under the terms and conditions of my Permit R-13385

Cathy Erickson (acting)



THIS MAP IS FOR THE PURPOSE OF LOCATING A WATER RIGHT AND IS NOT INTENDED TO PROVIDE LEGAL DIMENSIONS FOR LOCATION OF PROPERTY BOUNDARIES.

ACAD2005
DWG FILE: WOOLHAWK-BENE

UNITED STATES DEPARTMENT OF THE INTERIOR BUREAU OF LAND MANAGEMENT DIVISION OF OPERATIONS VALE DISTRICT	
WOOLHAWK (68-2138) RESERVOIR	
DESIGNED:	
REVIEWED:	
APPROVED:	<i>Cathy Erickson (acting)</i> ADM OPERATIONS AND FIELD SERVICES
DRAWN: CG	SCALE: 1"=1320'
DATE: 12/13/05	SHEET 1 OF 1
DRAWING NO. OR-03-9172.45-1234	