


CLAIM OF BENEFICIAL USE MAP

UNDER APPLICATION R-85153; PERMIT R-13392

GOV'T LOT 1 SEC 2 T 29S R 45S W.M.

U.S.G.S. QUAD - DOWNEY CANYON, OREG. - 7 1/2'

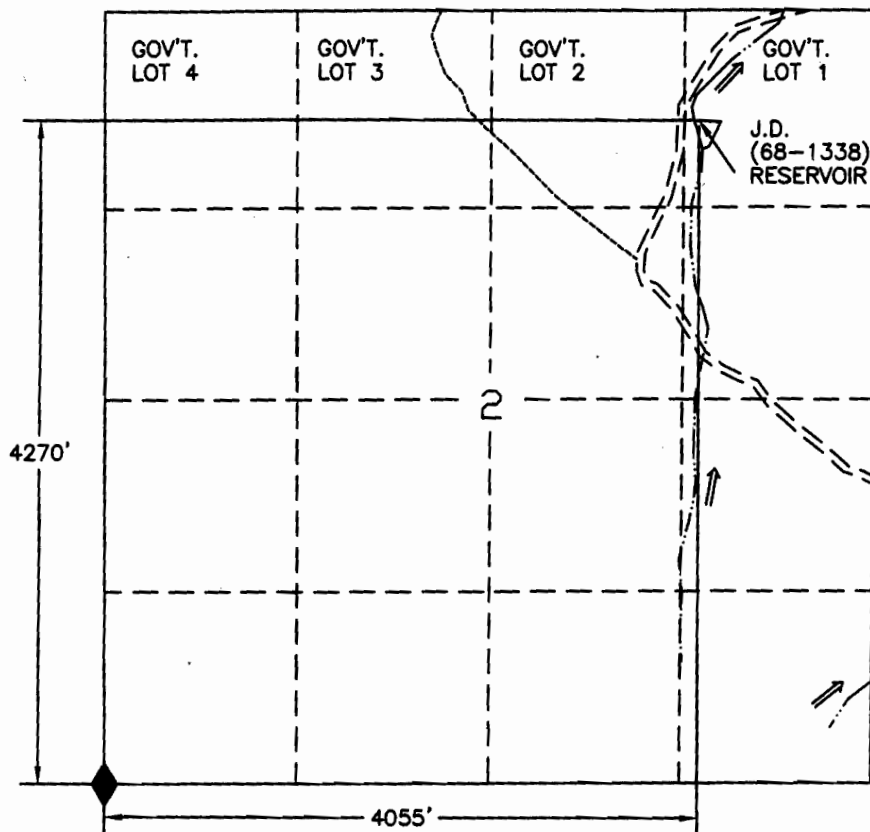

LEGEND

- RESERVOIR
- ROAD
- CHANNEL
- FD SEC COR
- TRAIL



RECEIVED

JAN 06 2006

WATER RESOURCES DEPT
SALEM, OREGON

J.D. (68-1338) RESERVOIR

1320 660 0 1320



SCALE 1"=1320'

I, Charles E. Joy, Administrative Officer, Vale BLM agree to the findings of the CWRE and do submit this site report and map as my Claim of Beneficial Use of the water as provided under the terms and conditions of my Permit R-13392

Cathy Grubbs (action)



THIS MAP IS FOR THE PURPOSE OF LOCATING A WATER RIGHT AND IS NOT INTENDED TO PROVIDE LEGAL DIMENSIONS FOR LOCATION OF PROPERTY BOUNDARIES.

ACAD2005
DWG FILE: JDRES-BENE

UNITED STATES DEPARTMENT OF THE INTERIOR
BUREAU OF LAND MANAGEMENT
DIVISION OF OPERATIONS VALE DISTRICT

J.D. (68-1338)
RESERVOIR

DESIGNED:		
REVIEWED:		
APPROVED:	<i>Cathy Grubbs (action)</i>	
DRAWN:	CG	SCALE: 1"=1320'
DATE:	12/13/05	SHEET 1 OF 1
DRAWING NO.	OR-03-9172.45-1235	