


CLAIM OF BENEFICIAL USE MAP

UNDER APPLICATION R-85145; PERMIT R-13388

SW1/4 SE1/4 SEC 26 T 34S R 45E W.M.

U.S.G.S. QUAD - THREE FORKS, OREG. - 7 1/2'

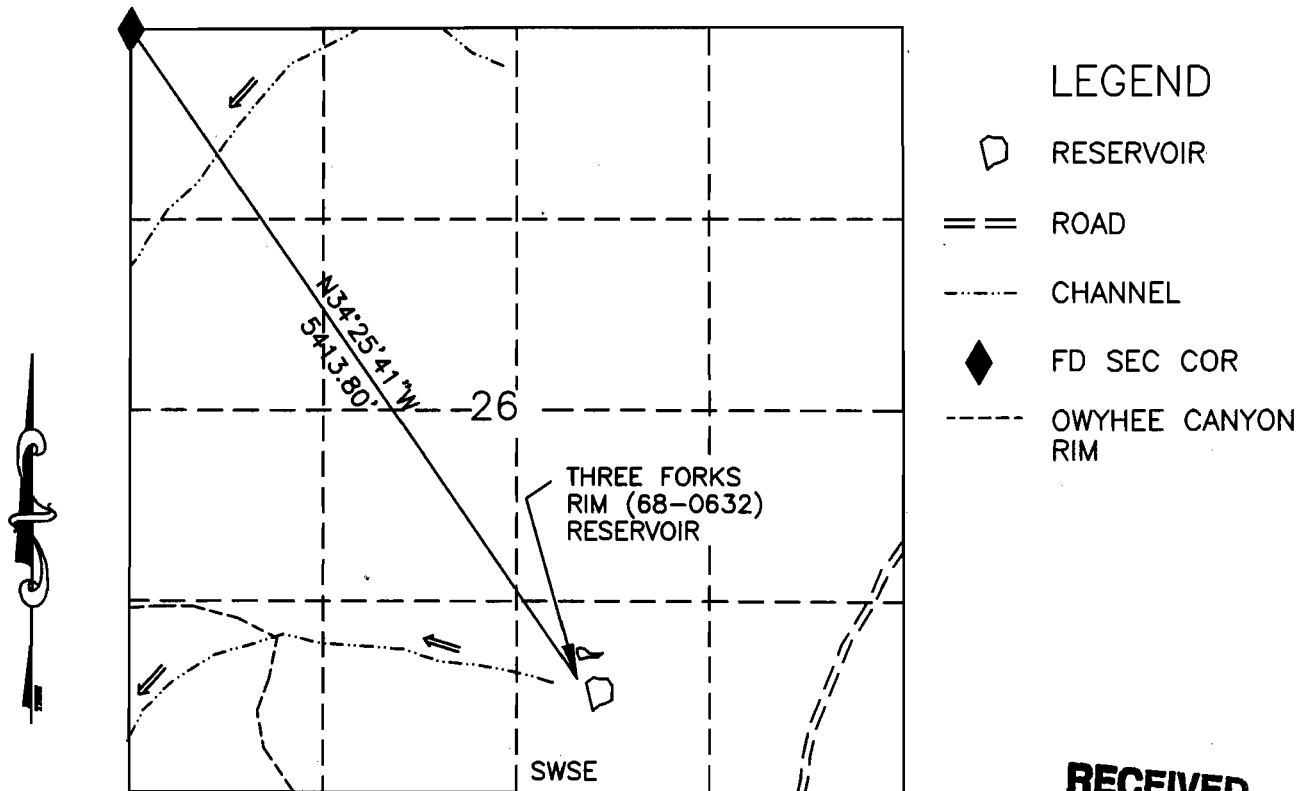

LEGEND



RESERVOIR



ROAD



CHANNEL



FD SEC COR



OWYHEE CANYON RIM

RECEIVED

JAN 06 2006

WATER RESOURCES DEPT
SALEM, OREGON

THREE FORKS RIM (68-0632) RESERVOIR

1320 660 0 1320
SCALE 1"=1320'

I, Charles E. Joy, Administrative Officer, Vale BLM agree to the findings of the CWRE and do submit this site report and map as my Claim of Beneficial Use of the water as provided under the terms and conditions of my Permit R-13388

Cathy Greubach (acting)

ALWAYS
THINK
SAFETY

THIS MAP IS FOR THE PURPOSE OF LOCATING A WATER RIGHT AND IS NOT INTENDED TO PROVIDE LEGAL DIMENSIONS FOR LOCATION OF PROPERTY BOUNDARIES.

ACAD2005
DWG FILE:3FORKSR-BENE

UNITED STATES DEPARTMENT OF THE INTERIOR BUREAU OF LAND MANAGEMENT DIVISION OF OPERATIONS VALE DISTRICT	
THREE FORKS RIM (68-0632) RESERVOIR	
DESIGNED:	
REVIEWED:	
APPROVED:	<i>Cathy Greubach (acting)</i> ADM OPERATIONS AND FIELD SERVICES
DRAWN: CG	SCALE: 1"=1320'
DATE: 12/13/05	SHEET 1 OF 1
DRAWING NO. OR-03-9172.45-1236	