


CLAIM OF BENEFICIAL USE MAP

UNDER APPLICATION R-85152; PERMIT R-13391

SE1/4 SW1/4 SEC 13 T 23S R 40E W.M.

U.S.G.S. QUAD - ALDER CREEK, OREG. - 7 1/2'

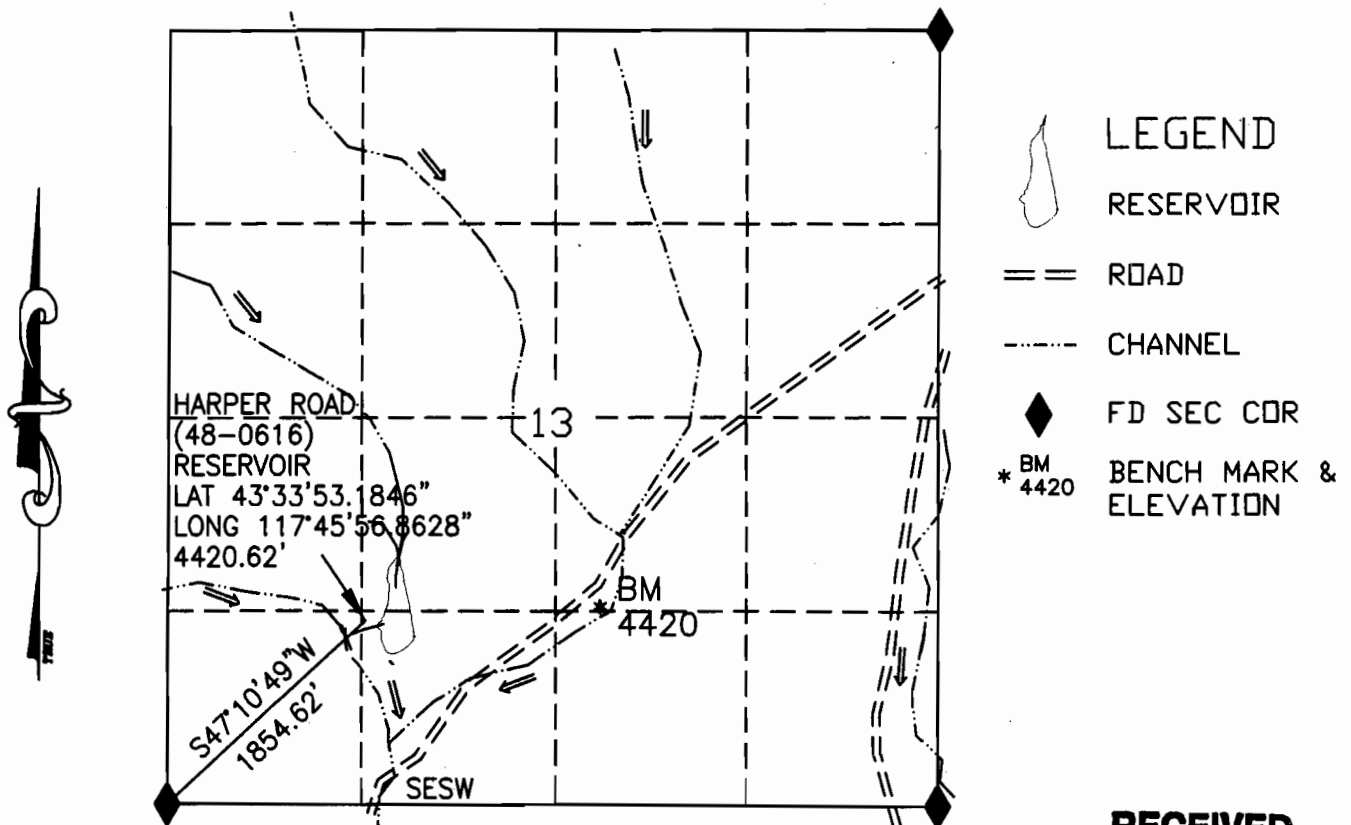

RECEIVED

JAN 06 2006

HARPER ROAD (48-0616) RESERVOIR

WATER RESOURCES DEPT
SALEM, OREGON

1320 660 0 1320
SCALE 1"=1320'

I, Charles E. Joy, Administrative Officer, Vale BLM agree to the findings of the CWRE and do submit this site report and map as my Claim of Beneficial Use of the water as provided under the terms and conditions of my Permit R-13391

Cathy Erickson (ack)



THIS MAP IS FOR THE PURPOSE OF LOCATING A WATER RIGHT AND IS NOT INTENDED TO PROVIDE LEGAL DIMENSIONS FOR LOCATION OF PROPERTY BOUNDARIES.

ACAD2005
DWG FILE: ACAD2005

UNITED STATES DEPARTMENT OF THE INTERIOR
BUREAU OF LAND MANAGEMENT
DIVISION OF OPERATIONS VALE DISTRICT

HARPER ROAD
(48-0616) RESERVOIR

DESIGNED: _____

REVIEWED: _____

APPROVED *Cathy Erickson (ack)*

DRAWN: CG SCALE: 1"=1320'

DATE: 12/14/05 SHEET 1 OF 1

DRAWING NO. OR-03-9172.45-1248