


CLAIM OF BENEFICIAL USE MAP

UNDER APPLICATION R-85140; PERMIT R-13383

NE1/4 SW1/4 SEC 17 T 23S R 40E W.M.

U.S.G.S. QUAD - ALDER CREEK, OREG. - 7 1/2'

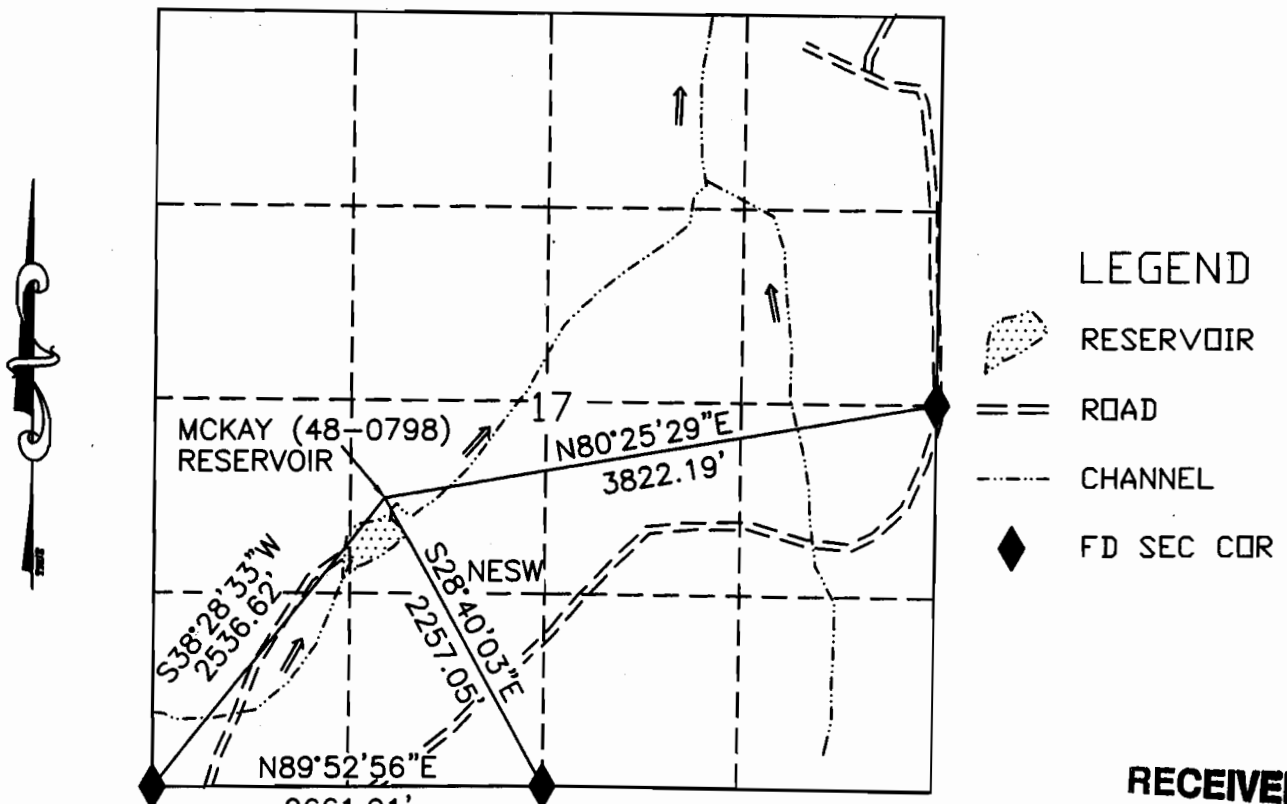

ENLARGEMENT OF:
APPLICATION R-36845
PERMIT R-3399
PRIORITY DATE: 08/08/61
FOR 2.50 ACRE FEET
ACTUAL 7.6 ACRE FEET

MCKAY (48-0798) RESERVOIR

RECEIVED

JAN 06 2006

WATER RESOURCES DEPT
SALEM, OREGON

1320 660 0 1320
SCALE 1"=1320'

I, Charles E. Joy, Administrative Officer, Vale BLM
agree to the findings of the CWRE and do submit
this site report and map as my Claim of Beneficial
Use of the water as provided under the terms and
conditions of my Permit R-13383

Colby Greenman (acting)



THIS MAP IS FOR THE PURPOSE OF LOCATING
A WATER RIGHT AND IS NOT INTENDED TO
PROVIDE LEGAL DIMENSIONS FOR LOCATION
OF PROPERTY BOUNDARIES.

ACAD2005
DWG FILE:MCKAY-BENE

UNITED STATES DEPARTMENT OF THE INTERIOR
BUREAU OF LAND MANAGEMENT
DIVISION OF OPERATIONS VALE DISTRICT

MCKAY (48-0798)
RESERVOIR

DESIGNED: SURVEY:9/19/00 NICKERSON/CURTIS

REVIEWED:

APPROVED

DRAWN: CG

DATE: 12/14/05

DRAWING NO. OR-03-9172.45-1250

SCALE: 1"=1320'

SHEET 1 OF 1