


CLAIM OF BENEFICIAL USE MAP

UNDER APPLICATION R-85129; PERMIT R-13374


SW1/4 SW1/4 SEC 22 T 27S R 44E W.M.

U.S.G.S. QUAD - MCCAIN CREEK, OREG. - 7 1/2'

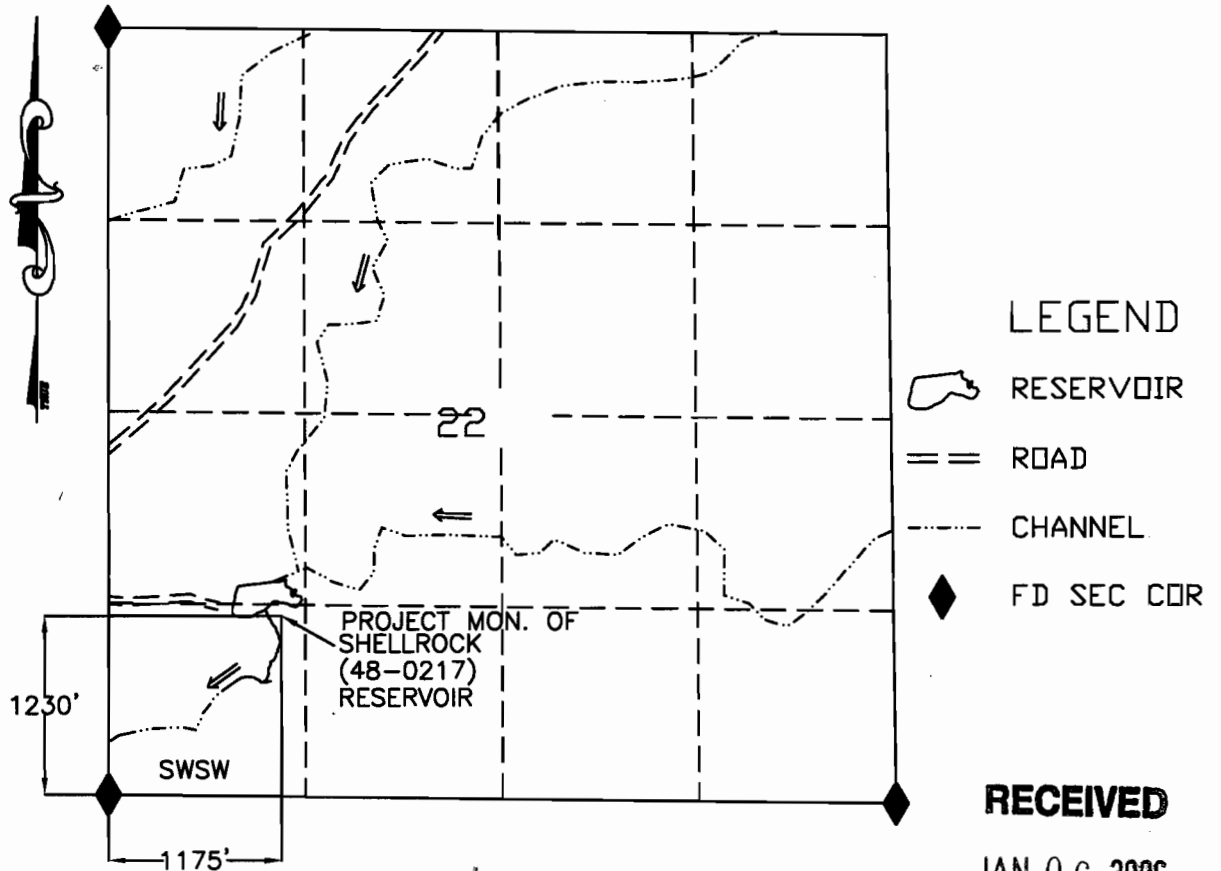

SHELL ROCK (48-0217) RESERVOIR

RECEIVED
 JAN 06 2006
 WATER RESOURCES DEPT
 SALEM, OREGON

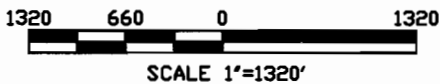

I, Charles E. Joy, Administrative Officer, Vale BLM agree to the findings of the CWRE and do submit this site report and map as my Claim of Beneficial Use of the water as provided under the terms and conditions of my Permit R-13374

Cathy Zambach (acting)



THIS MAP IS FOR THE PURPOSE OF LOCATING A WATER RIGHT AND IS NOT INTENDED TO PROVIDE LEGAL DIMENSIONS FOR LOCATION OF PROPERTY BOUNDARIES.

ACAD2005
 DWG FILE SHELLROCK-BENE

UNITED STATES DEPARTMENT OF THE INTERIOR BUREAU OF LAND MANAGEMENT DIVISION OF OPERATIONS VALE DISTRICT	
SHELL ROCK (48-0217) RESERVOIR	
DESIGNED:	_____
REVIEWED:	_____
APPROVED:	<i>Cathy Zambach (acting)</i> <small>ADM OPERATIONS AND FIELD SERVICES</small>
DRAWN:	CG
DATE:	12/14/05
DRAWING NO.	OR-03-9172.45-1240
SCALE:	1"=1320'
SHEET	1 OF 1