

# CLAIM OF BENEFICIAL USE MAP


UNDER APPLICATION R-85150; PERMIT R-13390

SW1/4 SW1/4 SEC 25 T 24S R 37E W.M.

U.S.G.S. - MCEWEN BUTTE, OREG. - 7 1/2'

## LEGEND

-  RESERVOIR
-  ROAD
-  CHANNEL
-  FD SEC COR
-  FENCE

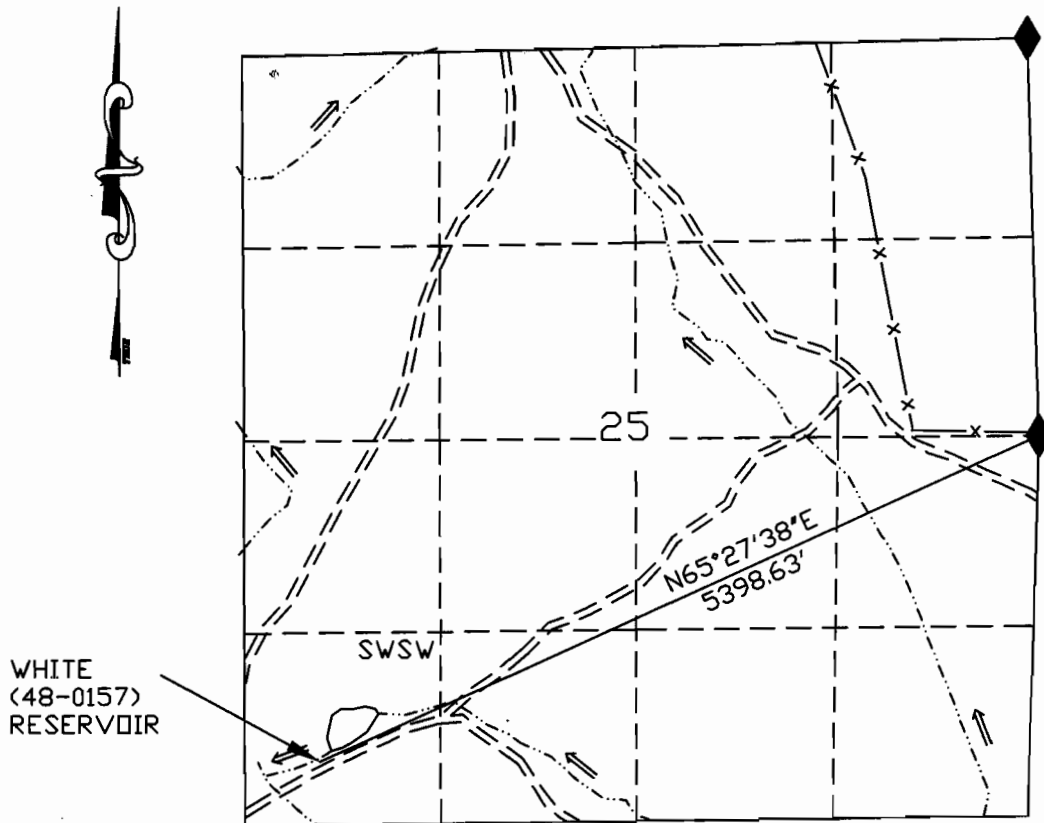

RECEIVED

JAN 06 2006

WATER RESOURCES DEPT  
SALEM, OREGON

WHITE (48-0157) RESERVOIR

1320 660 0 1320  
SCALE 1"=1320'

I, Charles E. Joy, Administrative Officer, Vale BLM agree to the findings of the CWRE and do submit this site report and map as my Claim of Beneficial Use of the water as provided under the terms and conditions of my Permit R-13390

*Cathy Greider (acting)*



THIS MAP IS FOR THE PURPOSE OF LOCATING A WATER RIGHT AND IS NOT INTENDED TO PROVIDE LEGAL DIMENSIONS FOR LOCATION OF PROPERTY BOUNDARIES.

ACAD2005  
DWG FILE: WHITE-BENE

UNITED STATES DEPARTMENT OF THE INTERIOR  
BUREAU OF LAND MANAGEMENT  
DIVISION OF OPERATIONS VALE DISTRICT

WHITE (48-0157)  
RESERVOIR

DESIGNED: \_\_\_\_\_

REVIEWED: \_\_\_\_\_

APPROVED *Cathy Greider (acting)*  
ADM OPERATIONS AND FIELD SERVICES

DRAWN: CG SCALE: 1"=1320'

DATE: 12/13/05 SHEET 1 OF 1

DRAWING NO. OR-03-9172.45-1239