


CLAIM OF BENEFICIAL USE MAP

UNDER APPLICATION R-85138 ; PERMIT R-13381

NE1/4 NW1/4 SEC 7 T 23S R 42E W.M.
U.S.G.S. QUAD - HURLEY FLAT, OREG. - 7 1/2'

FOUND NW COR
SECTION 6
T.23S., R.42E., W.M.

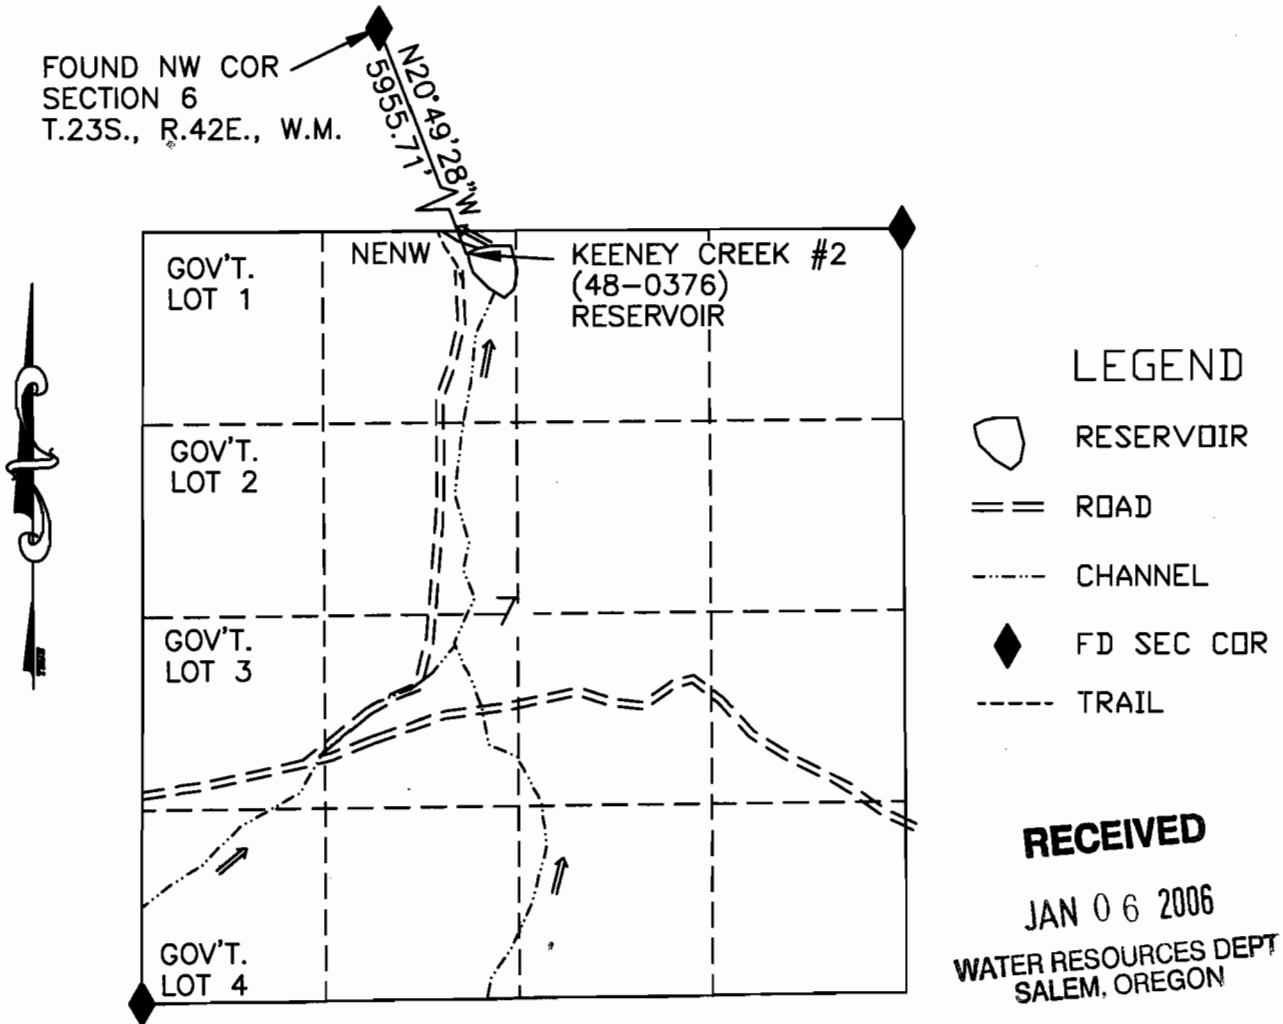

KEENEY CREEK #2 (48-0376) RESERVOIR

1320 660 0 1320
SCALE 1"=1320'

I, Charles E. Joy, Administrative Officer, Vale BLM agree to the findings of the CWRE and do submit this site report and map as my Claim of Beneficial Use of the water as provided under the terms and conditions of my Permit R-13381

Calvin Greulich (acting)



THIS MAP IS FOR THE PURPOSE OF LOCATING A WATER RIGHT AND IS NOT INTENDED TO PROVIDE LEGAL DIMENSIONS FOR LOCATION OF PROPERTY BOUNDARIES.

ACAD2005
DWG FILE: KEENEY2-BENE

UNITED STATES DEPARTMENT OF THE INTERIOR
BUREAU OF LAND MANAGEMENT
DIVISION OF OPERATIONS VALE DISTRICT

KEENEY CREEK #2 (48-0376) RESERVOIR

DESIGNED: _____

REVIEWED: _____

APPROVED: *Calvin Greulich (acting)*
ADM OPERATIONS AND FIELD SERVICES

DRAWN: CG SCALE: 1"=1320'

DATE: 12/14/05 SHEET 1 OF 1

DRAWING NO. OR-03-9172.45-1244