


CLAIM OF BENEFICIAL USE MAP

UNDER APPLICATION R-85137; PERMIT R-13380

NE1/4 SE1/4 SEC 18 T 22S R 39E W.M.

U.S.G.S. QUAD MONUMENT PEAK, OREG. - 7 1/2'

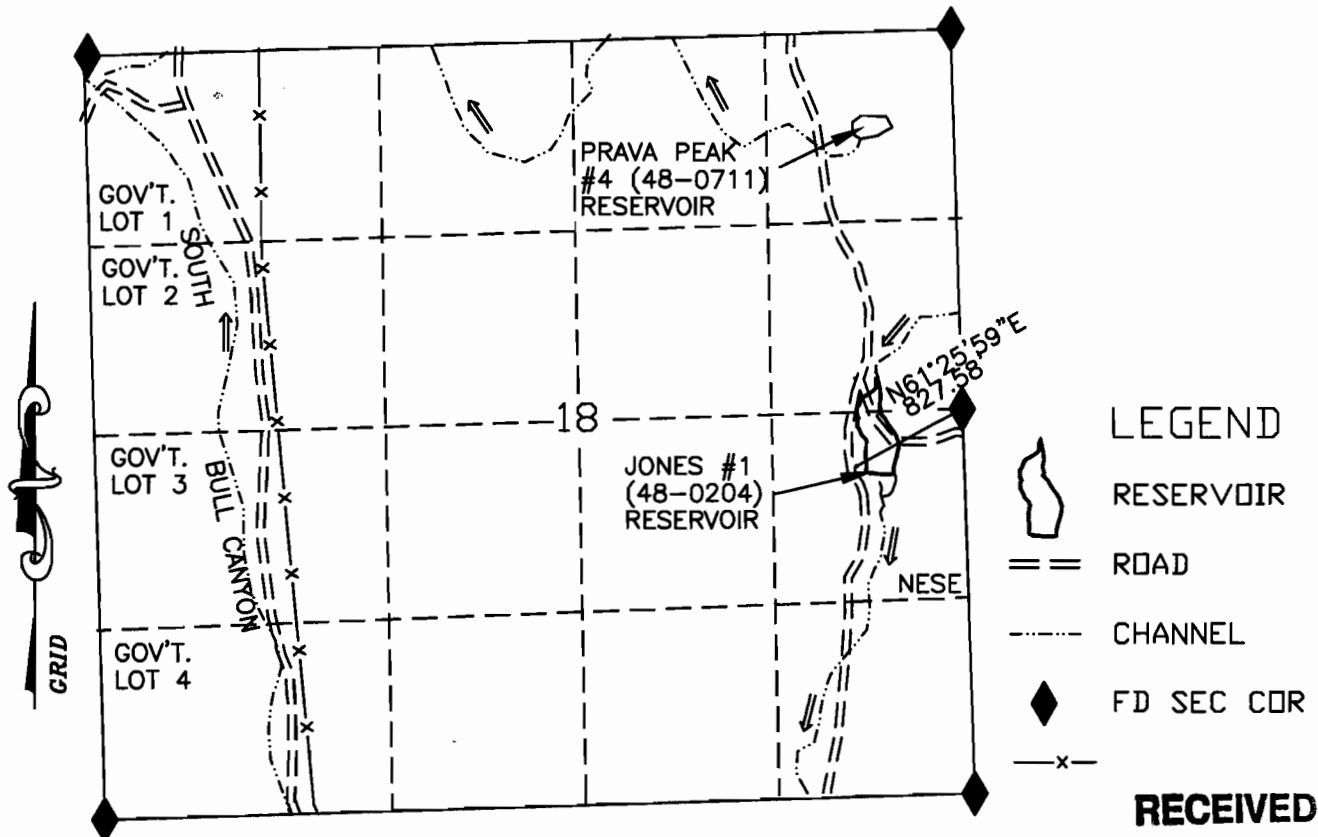

JONES #1 (48-0204) RESERVOIR

WATER RESOURCES DEPT
SALEM, OREGON

1320 660 0 1320
SCALE 1"=1320'

I, Charles E. Joy, Administrative Officer, Vale BLM agree to the findings of the CWRE and do submit this site report and map as my Claim of Beneficial Use of the water as provided under the terms and conditions of my Permit R-13380

Charles E. Joy



THIS MAP IS FOR THE PURPOSE OF LOCATING A WATER RIGHT AND IS NOT INTENDED TO PROVIDE LEGAL DIMENSIONS FOR LOCATION OF PROPERTY BOUNDARIES.

ACAD2005
DWG FILE JONES1-BENE

UNITED STATES DEPARTMENT OF THE INTERIOR BUREAU OF LAND MANAGEMENT DIVISION OF OPERATIONS VALE DISTRICT	
JONES #1 (48-0204) RESERVOIR	
DESIGNED:	
REVIEWED:	
APPROVED:	<i>Charles E. Joy</i> ADM OPERATIONS AND FIELD SERVICES
DRAWN: CG	SCALE: 1"=1320'
DATE: 12/14/05	SHEET 1 OF 1
DRAWING NO. OR-03-9172.45-1245	