


CLAIM OF BENEFICIAL USE MAP

UNDER APPLICATION R-84572; PERMIT R-13066

SW1/4 SW1/4 SEC 2 T 23S R 41E W.M.

U.S.G.S. QUAD - RUFIND BUTTE, OREG. - 7 1/2'

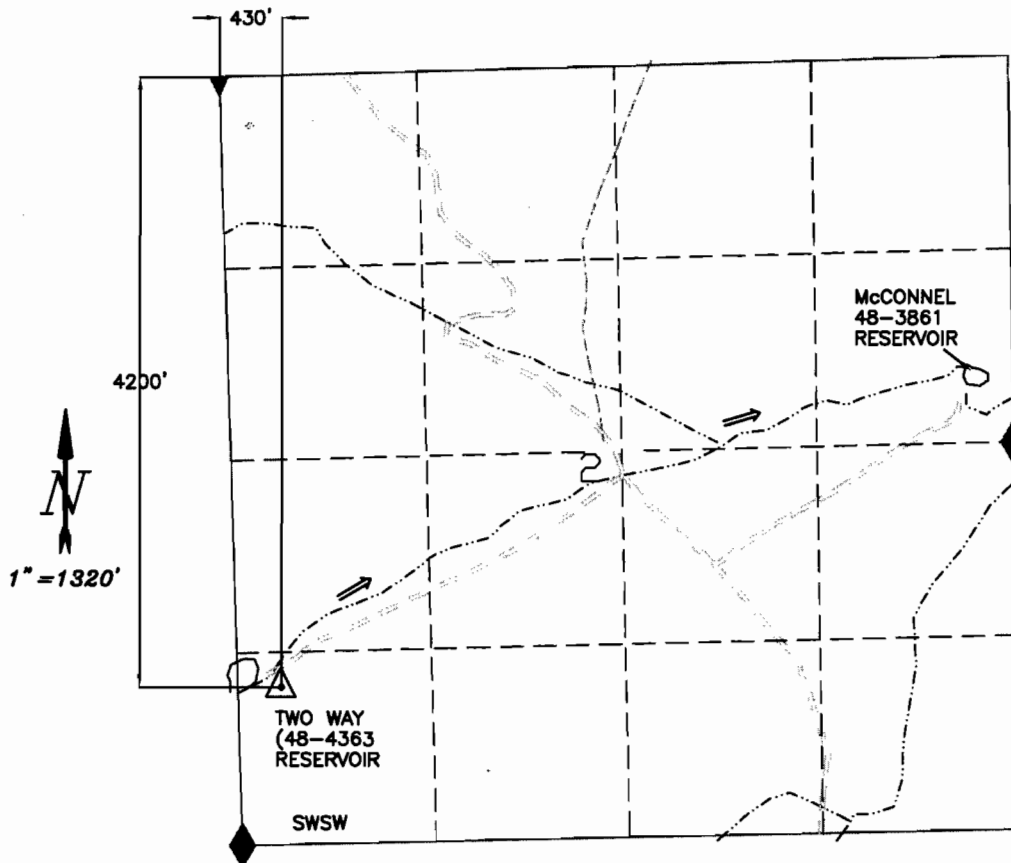

LEGEND


- RESERVOIR
- ROAD
- CHANNEL
- FD SEC COR
- PROJECT MON.

RECEIVED

JAN 06 2006

WATER RESOURCES DEPT
SALEM, OREGON

TWO WAY (48-4363) RESERVOIR

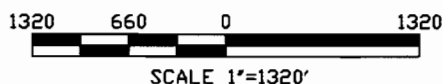

I, Charles E. Joy, Administrative Officer, Vale BLM agree to the findings of the CWRE and do submit this site report and map as my Claim of Beneficial Use of the water as provided under the terms and conditions of my Permit R-13066

Cathy Enrich (actd)



THIS MAP IS FOR THE PURPOSE OF LOCATING A WATER RIGHT AND IS NOT INTENDED TO PROVIDE LEGAL DIMENSIONS FOR LOCATION OF PROPERTY BOUNDARIES.

ACAD2005
DWG FILE: TWOWAY.DWG

UNITED STATES DEPARTMENT OF THE INTERIOR
BUREAU OF LAND MANAGEMENT
DIVISION OF OPERATIONS VALE DISTRICT

TWO WAY (48-4363) RESERVOIR

DESIGNED: _____
REVIEWED: _____
APPROVED: *Cathy Enrich (actd)*
ADMINISTRATIVE OPERATIONS AND FIELD SERVICES

DRAWN: CG SCALE: 1"=1320'
DATE: 12/15/05 SHEET 1 OF 1
DRAWING NO. OR-03-9172.45-1252