


CLAIM OF BENEFICIAL USE MAP

UNDER APPLICATION R-85148; PERMIT R-13389

SE1/4 NW1/4 SEC 19 T 22S R 39E W.M.

U.S.G.S. QUAD MONUMENT PEAK, OREG. - 7 1/2'

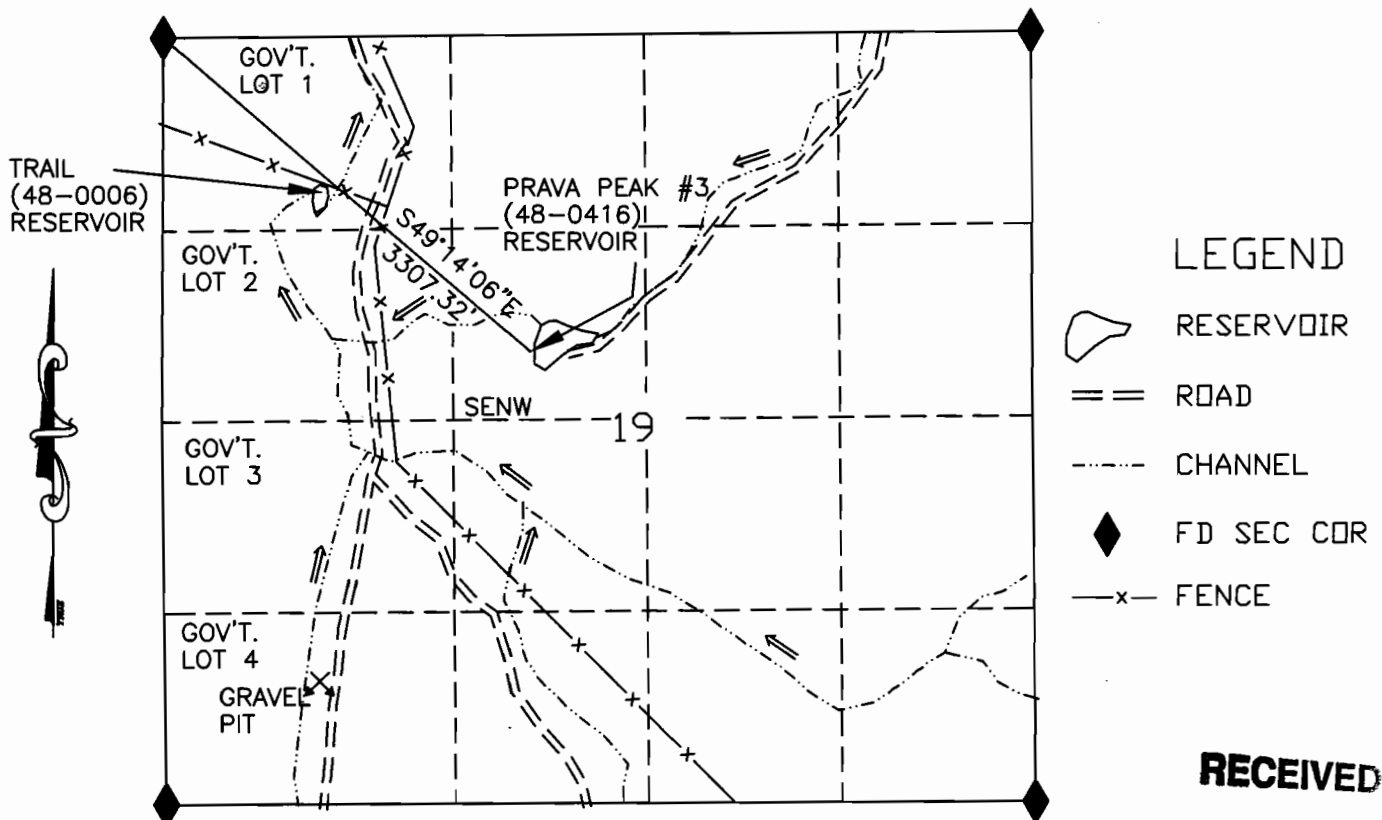


PRAVA PEAK #3 (48-0416) RESERVOIR

RECEIVED

JAN 06 2006

WATER RESOURCES DEPT
SALEM, OREGON

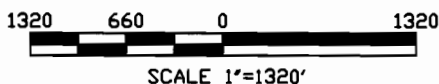

I, Charles E. Joy, Administrative Officer, Vale BLM agree to the findings of the CWRE and do submit this site report and map as my Claim of Beneficial Use of the water as provided under the terms and conditions of my Permit R-13389

Cathy Grodach (acting)



THIS MAP IS FOR THE PURPOSE OF LOCATING A WATER RIGHT AND IS NOT INTENDED TO PROVIDE LEGAL DIMENSIONS FOR LOCATION OF PROPERTY BOUNDARIES.

ACAD2005
DWG FILEPRAVA3-BENE

UNITED STATES DEPARTMENT OF THE INTERIOR
BUREAU OF LAND MANAGEMENT
DIVISION OF OPERATIONS VALE DISTRICT

PRAVA PEAK #3
(48-0416) RESERVOIR

DESIGNED: _____

REVIEWED: _____

APPROVED: *Cathy Grodach (acting)*

DRAWN: CG SCALE: 1"=1320'

DATE: 12/14/05 SHEET 1 OF 1

DRAWING NO. OR-03-9172.45-1246