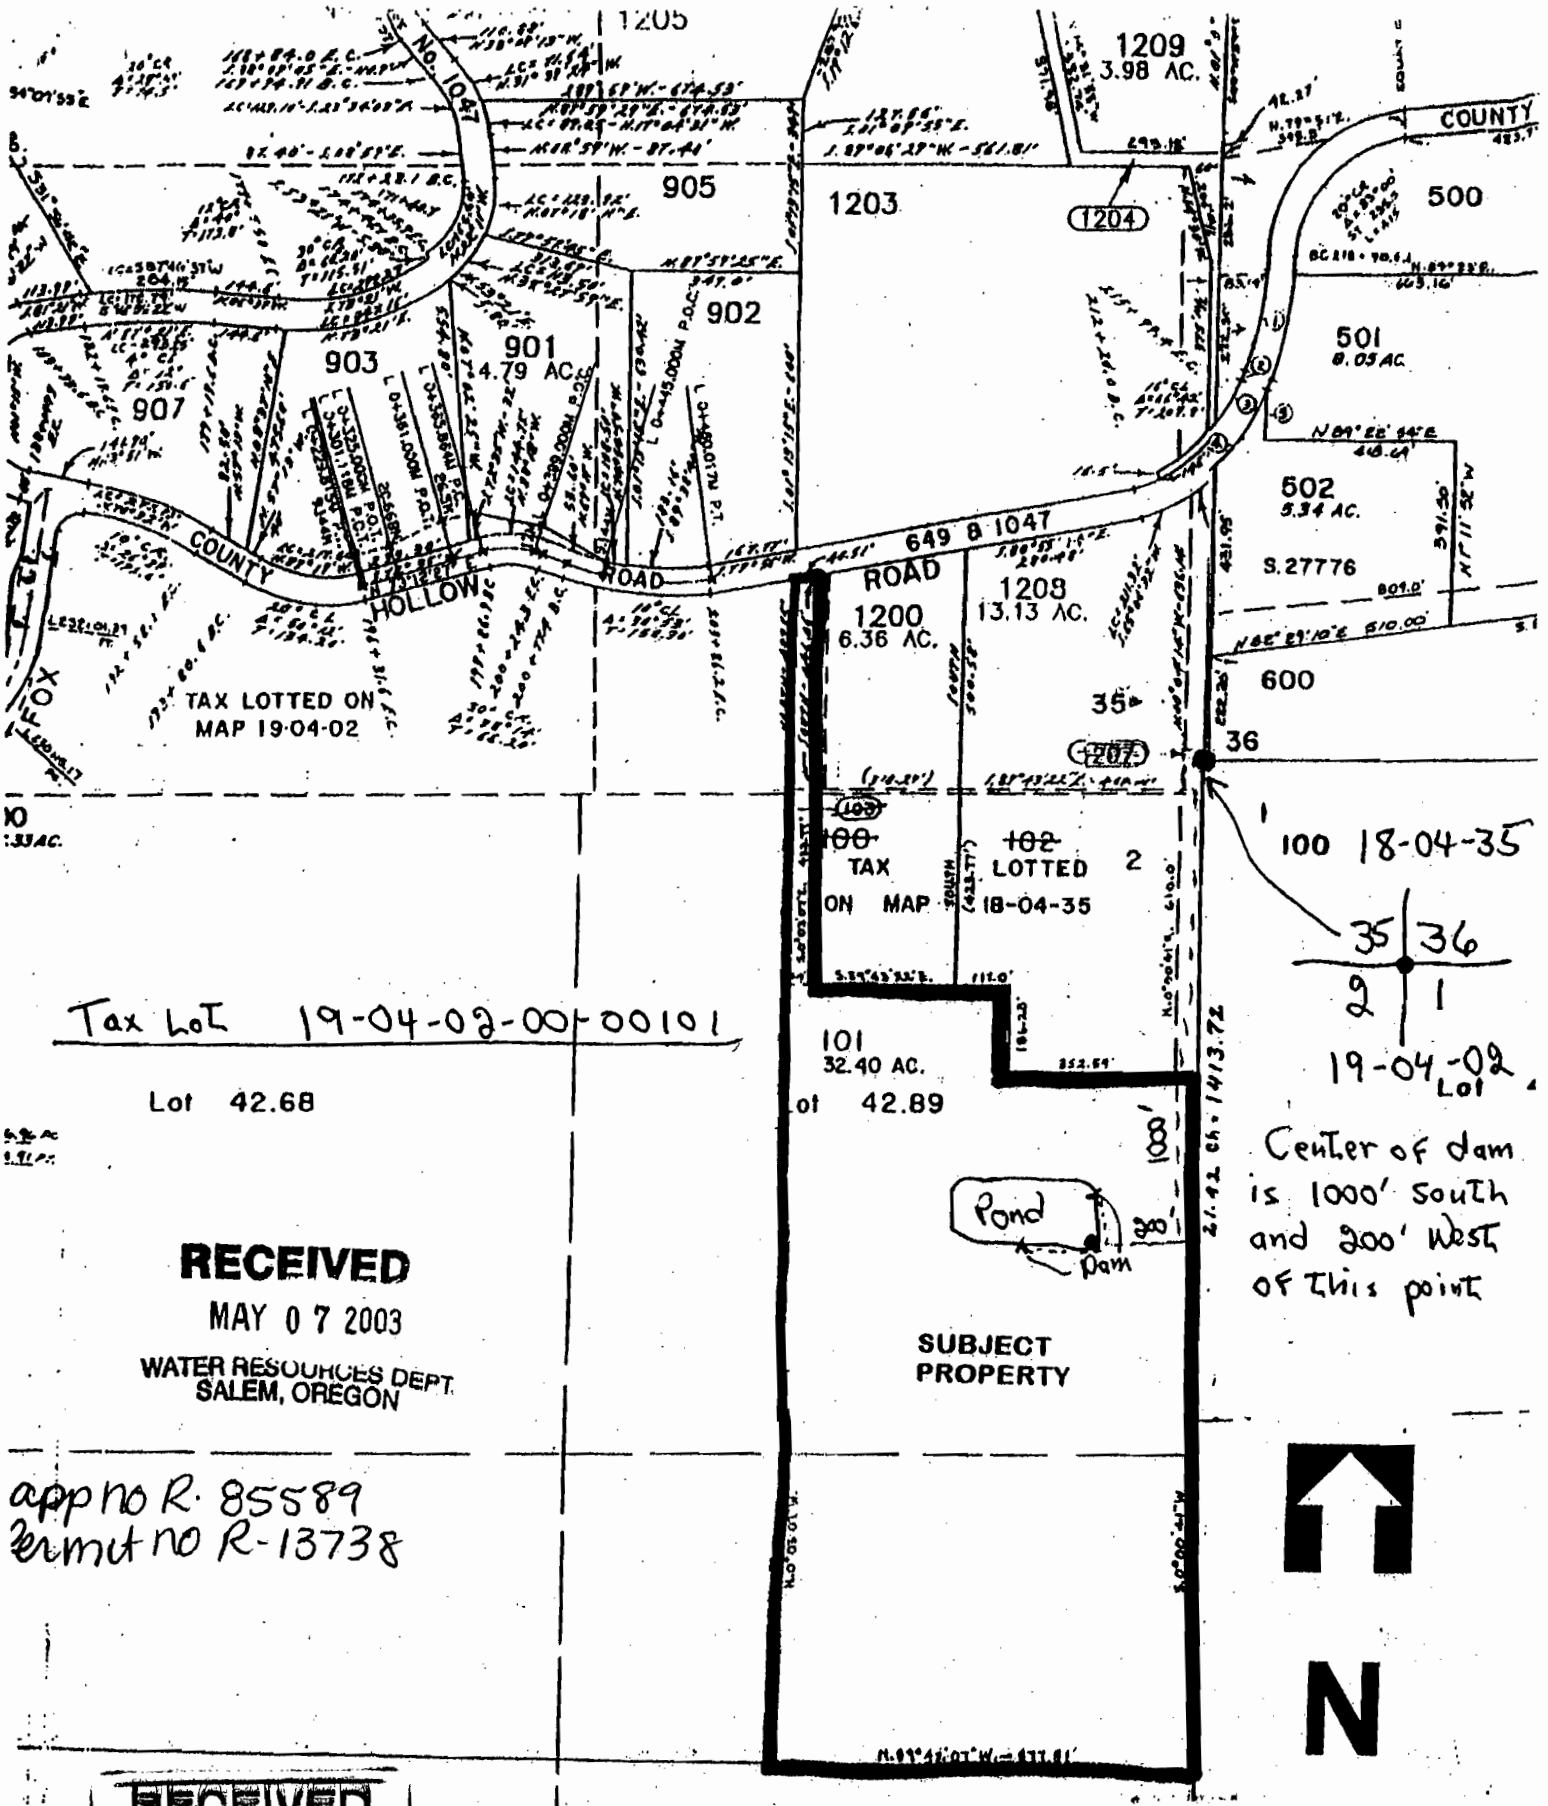

RECEIVED
MAY 07 2003
WATER RESOURCES DEPT
SALEM, OREGON

app no R-85589
permit no R-13738

RECEIVED
JUN 02 2005
WATER RESOURCES DEPT
SALEM, OREGON

EXHIBIT 'B'