


T. 5S. R. 1W. W.M.

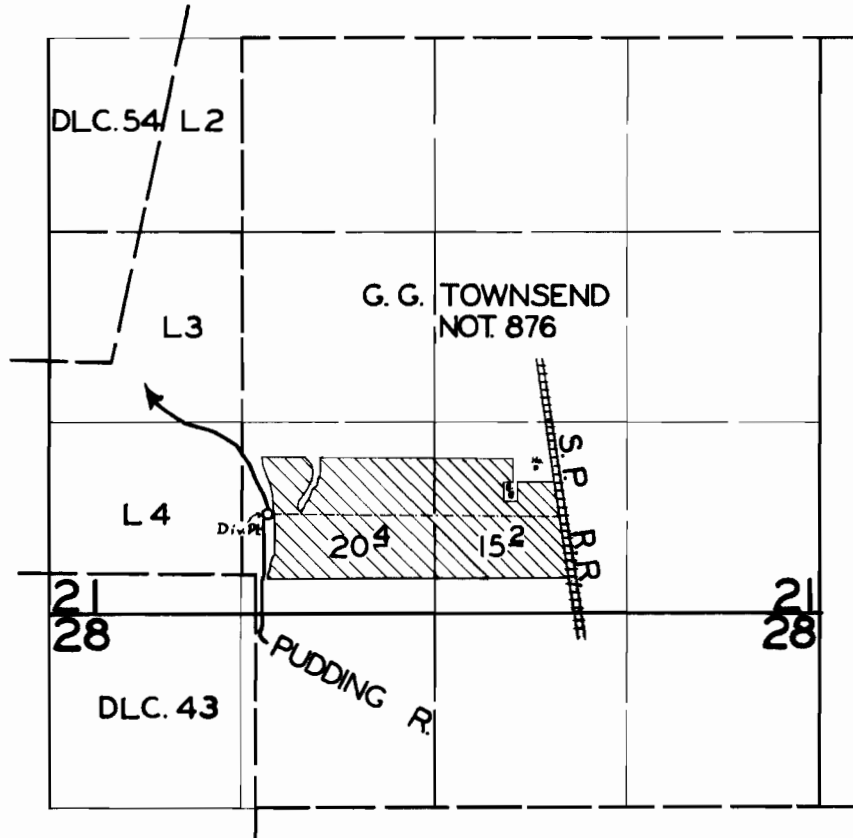

**FINAL PROOF SURVEY**  
UNDER

Application No. **25433** Permit No. **20217**  
IN NAME OF

**CLIFFORD HALKINRUD**

Surveyed **29 FEB. 1956**, by **R. D. BEST**

DFN-2D-207

RLB