
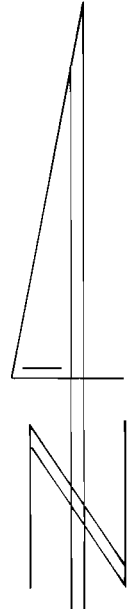


# T. 1 N., R. 7 W., W.M.

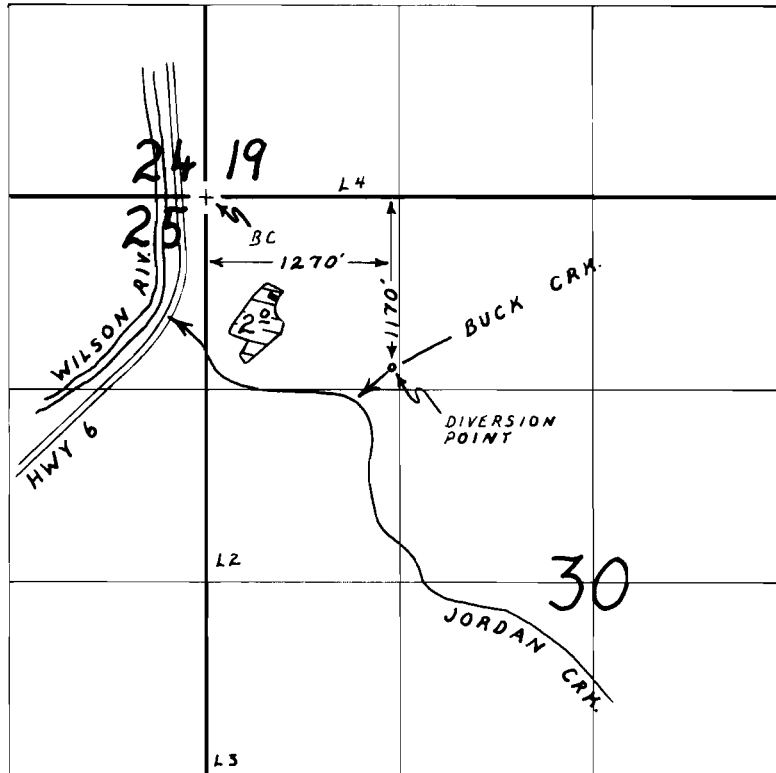

1" = 1320'

## FINAL PROOF SURVEY

UNDER

Application No. 53245 Permit No. 39512  
IN NAME OF

SAINT JOHNS BACHELOR CLUB

Surveyed July 21, 1993, by R.W. Klassen