


T.28S.R.7W.W.M.

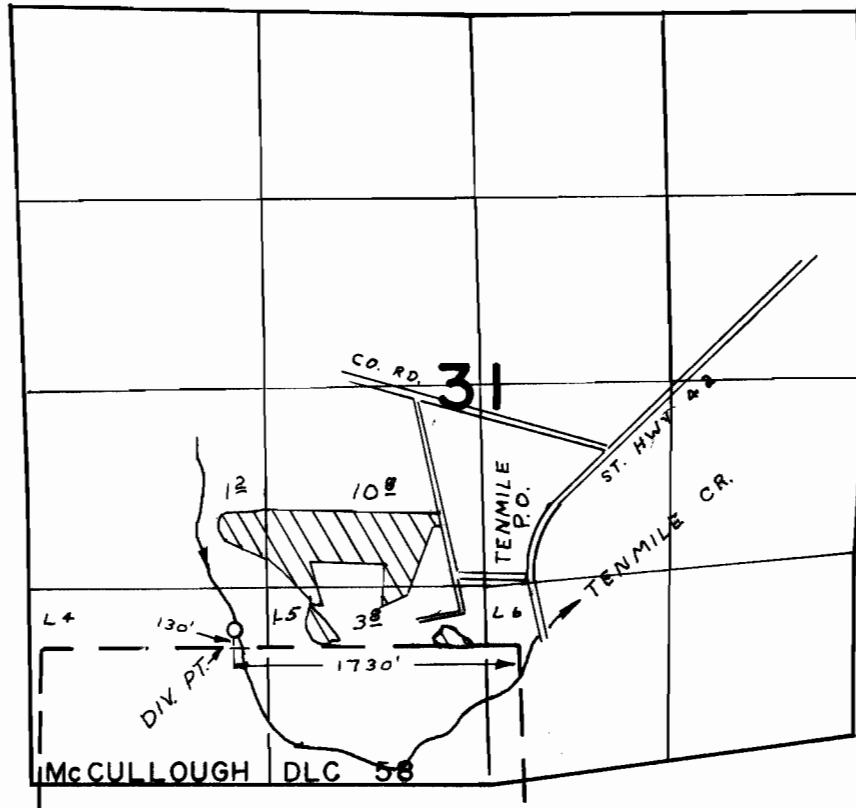

FINAL PROOF SURVEY UNDER

Application No. 39908 Permit No. 29705
IN NAME OF

Paul V. Brown & Paul R. Roach

Surveyed AUG. 28. 1974. by L. H. NUNN