
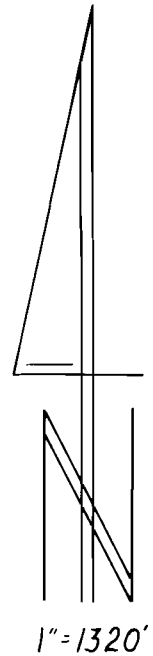


T. 6 N., R. 6 W., W.M.

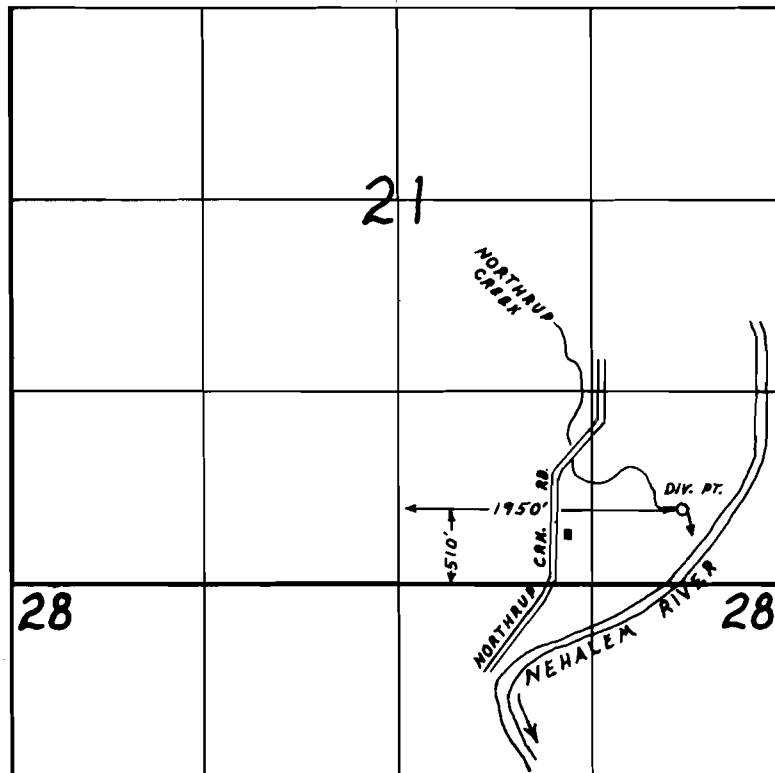

FINAL PROOF SURVEY

UNDER

Application No. 68307 Permit No. 49274
IN NAME OF

LAUREN J. & AARON D. JACOBSEN

Surveyed JULY 14, 1992, by R.W. Klassen