Transfer of water rights

Certificate 62338

Township 37 South, Range 4 West, Sec 30, W.M.

August 7, 2002

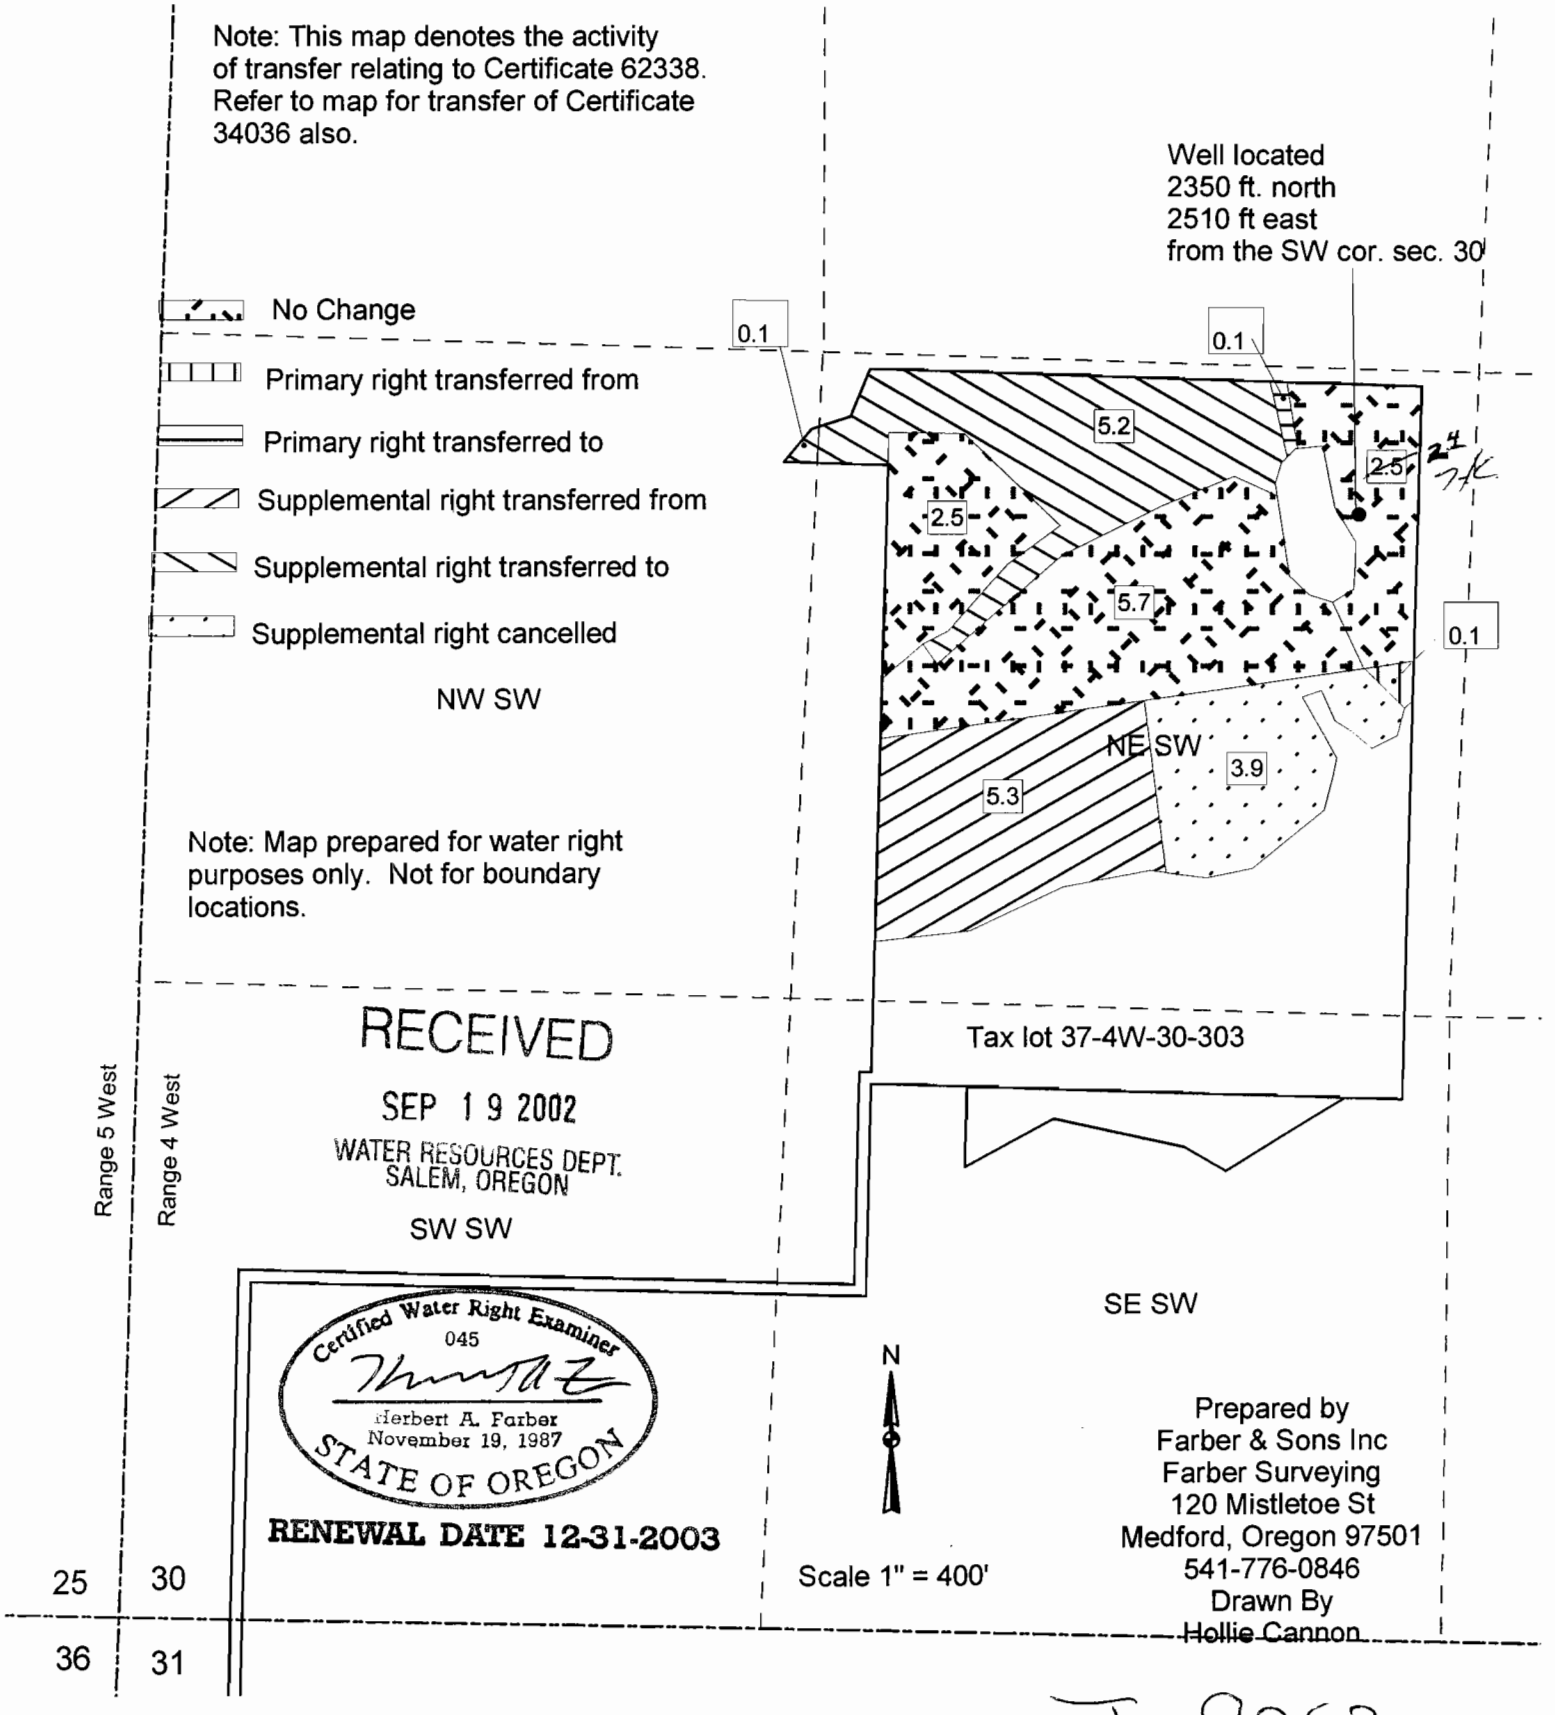

RECEIVED
SEP 19 2002
WATER RESOURCES DEPT.
SALEM, OREGON

Certified Water Right Examiner
045
Herbert A. Farber
November 19, 1987
STATE OF OREGON

RENEWAL DATE 12-31-2003

Prepared by
Farber & Sons Inc
Farber Surveying
120 Mistletoe St
Medford, Oregon 97501
541-776-0846
Drawn By
Hollie Cannon

T-9253

T.37S., R.4&5W., W.M.

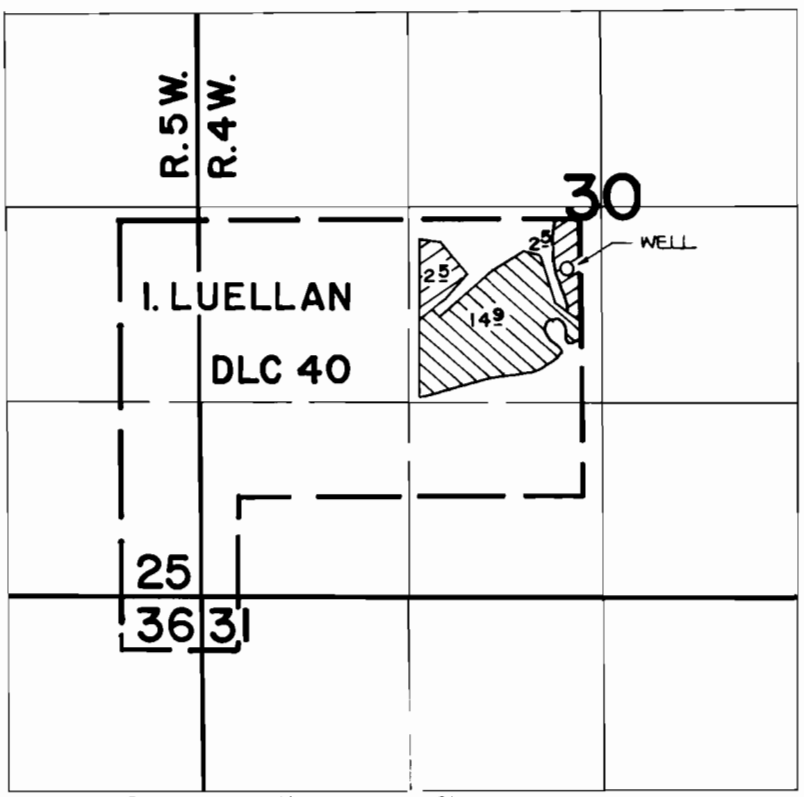

WELL IS LOCATED 2350'N. AND 2510'E. FROM THE S.W. CORNER OF SECTION 30.

PRIMARY SUPPLEMENTAL

FINAL PROOF SURVEY

UNDER

Application No. G-8810 Permit No. G-8207

IN NAME OF

DOUGLAS L. TRENERY

Surveyed APR. 30 1982, by B. SUND