


# T. 2 S., R. 4 W., W.M.

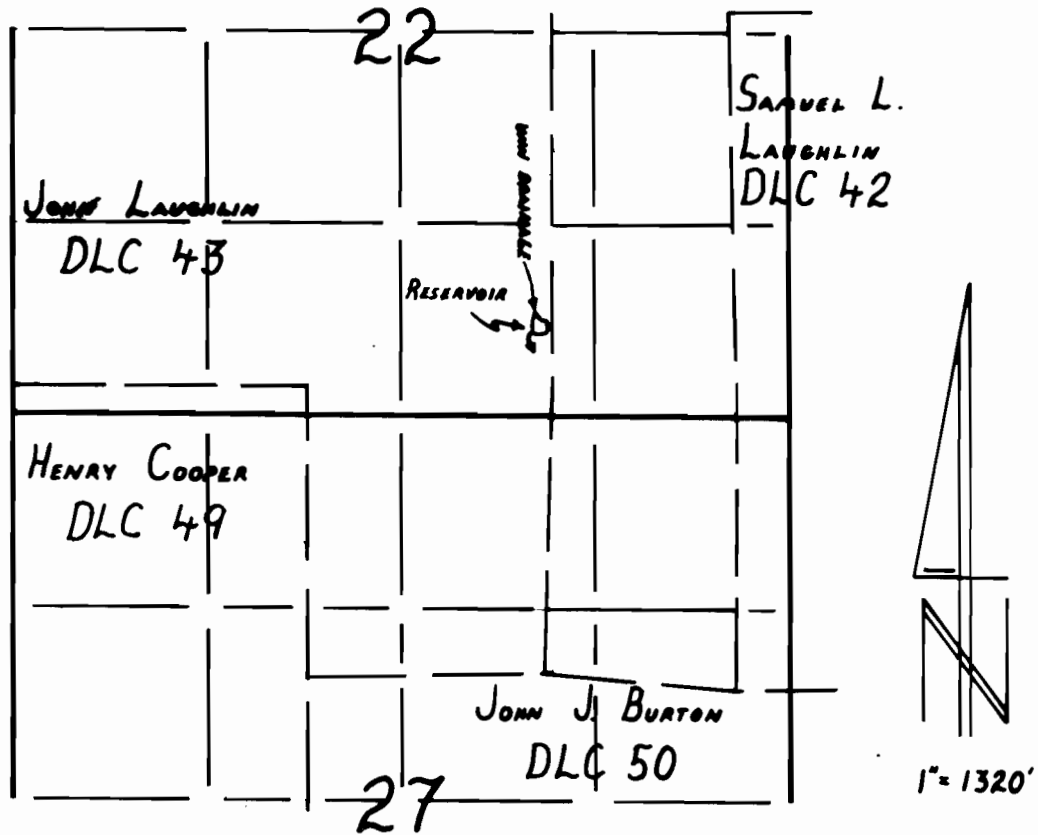

## FINAL PROOF SURVEY

UNDER

Application No. R-56478 Permit No. R-6743  
IN NAME OF

WWC RANCH, INC.

Surveyed MARCH 4, 1991, by R.W. Klassen