


T. 3 S., R. 2 W., W.M.

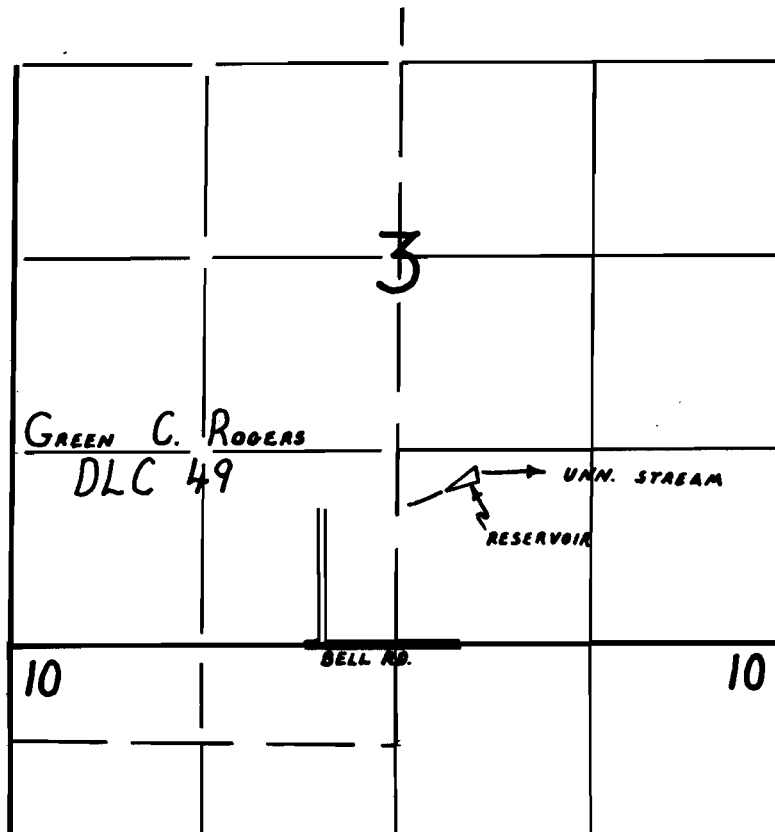

FINAL PROOF SURVEY

UNDER

Application No. R-68358 68359 Permit No. R-10507 49381
IN NAME OF

CHARLES HAGANS

Surveyed FEBRUARY 28, 1991, by R.W. Klassen