


T.14S., R.2W., W.M.

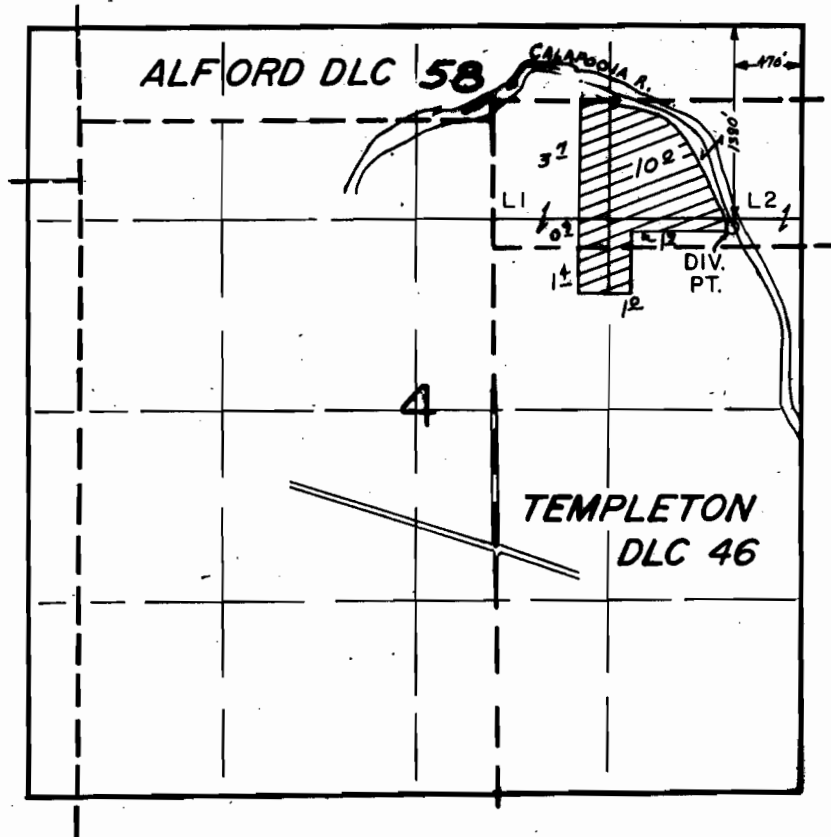

SCALE: 1" = 1320'

FINAL PROOF SURVEY

UNDER

Application No. 55479 Permit No. 41869
IN NAME OF

MR. & MRS. ALBERT F. CIERI

Surveyed JUNE 12 1984, by L. M. TOLL

JING 3/6/06
DFW 4/12/06