

LEGEND

LINE TYPES

- TAX MAP BOUNDARY
- 400 PERMANENT LINE
- ROAD RIGHT-OF-WAY
- VACATED RIGHT-OF-WAY
- RAILROAD
- NATIONAL RIGHT-OF-WAY
- ORIGINAL LATE DEC. TAX MAP BOUNDARY
- ORIGINAL LATE DEC. NON-BOUNDARY
- REVISIONS BOUNDARY
- PARTITION PLAT BND.
- TAX MAP BOUNDARY
- BOUNDARY

SYMBOL TYPES

- D.L.C.
- CENTRAL POINT
- PROPERTY BOUNDARY
- U.L.A. CORNER
- SECTION
- 1/4 SEC.
- 1/2 SEC.
- 3/4 SEC.
- 1/8 SEC.
- 1/16 SEC.


NUMBERS

- TAX MAP NO.
 - 000 00 00 0

NOTICE: This map was checked for Assessor's Office use ONLY.



SCALE 1" = 200'
 or 1:200
 Plot file created: March 20, 1998

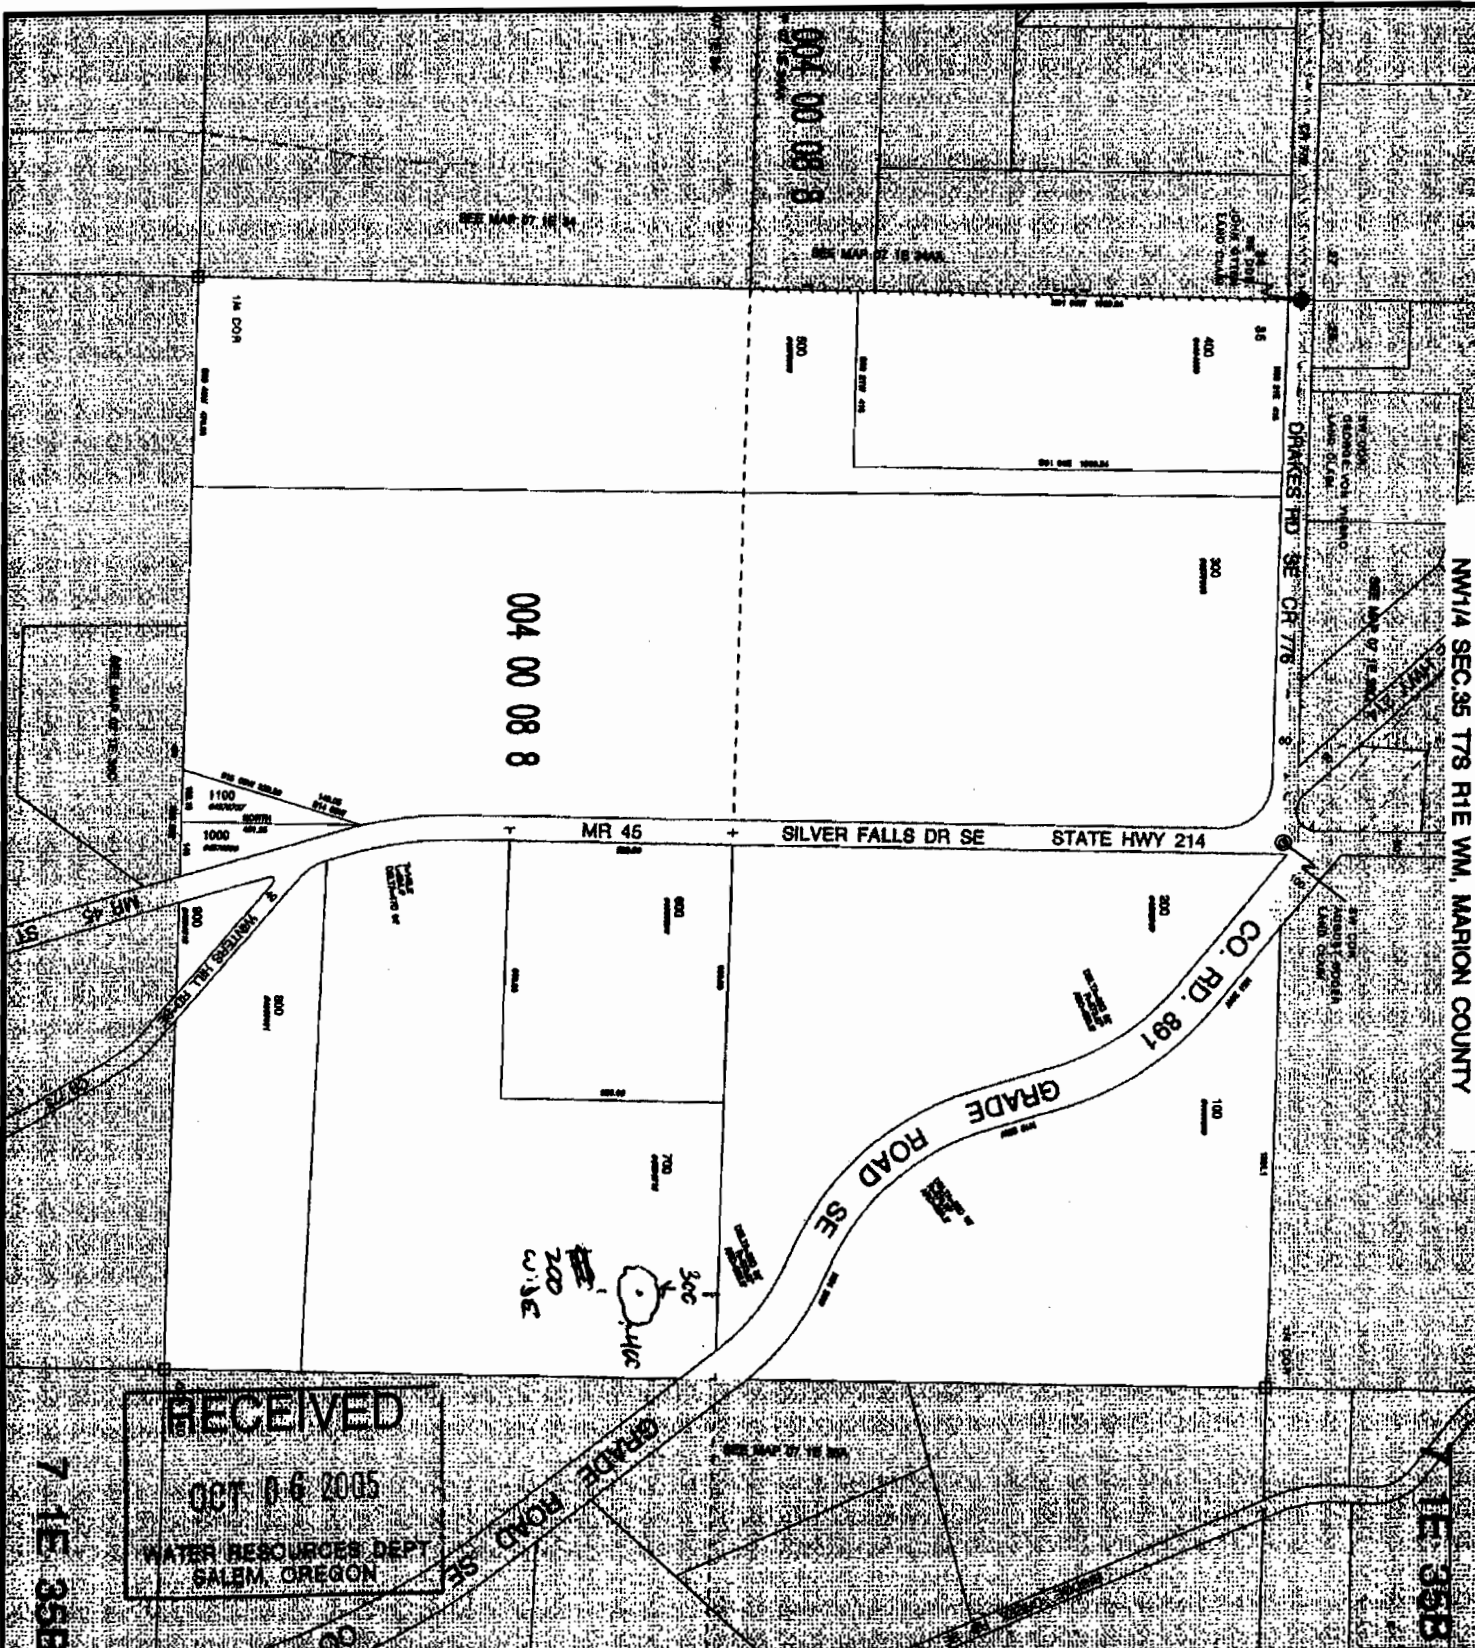

RECEIVED
 WATER RESOURCES DEPT
 SALEM, OREGON

7 1E 35B

7 1E 35B