

T 6 S, R 6 W, WM


POLK COUNTY

RECEIVED

NOV 03 2005

WATER RESOURCES DEPT
SALEM, OREGON

TAX LOTS:
6 6 8 200
6 6 9 1000
6 6 16 203

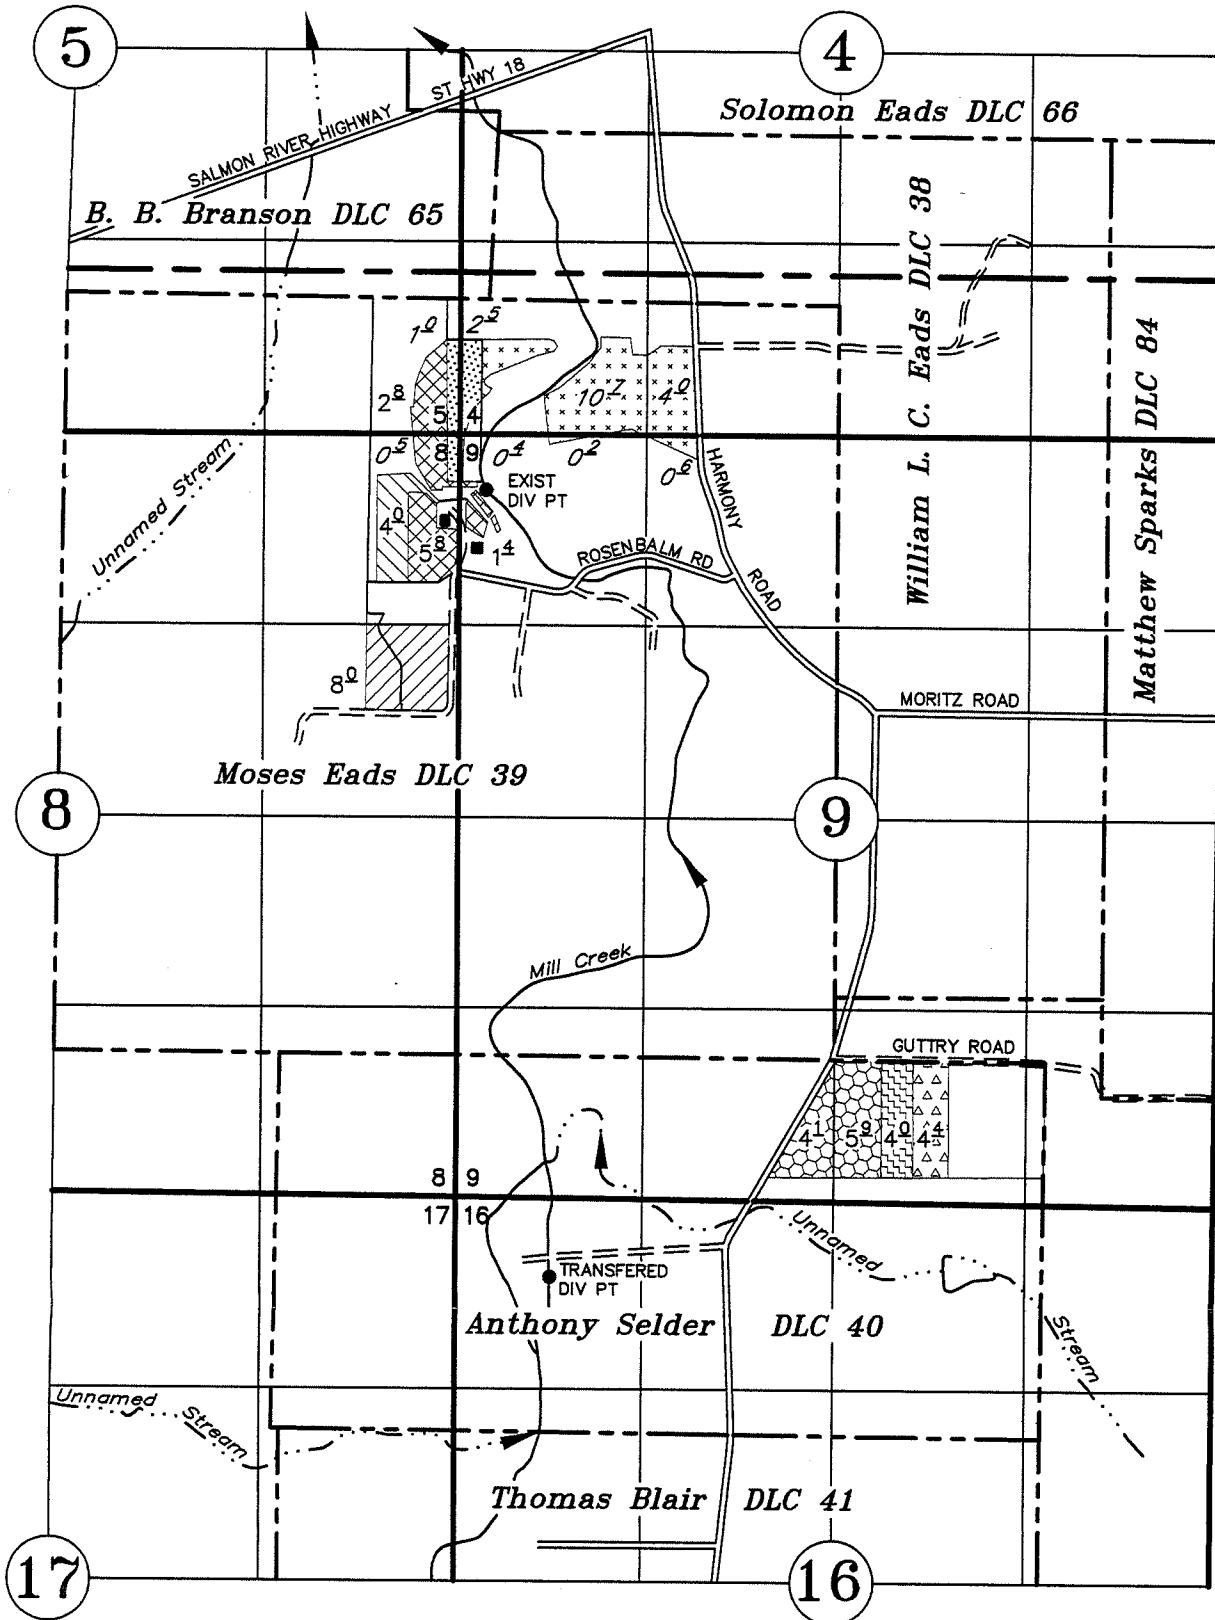

YAMHILL COUNTY
POLK COUNTY



EXIST DIV PT: NW 1/4, NW 1/4, SECTION 9, T 6 S, R 6 W, WM, WITHIN MOSES EADS DLC 39
TRANSFERED DIV PT: 1070' N & 1920' E, SW COR SELDER DLC NO 40

- EXIST WATER RIGHT, CERIFICATE 14476, TO TRANSFER (10.0 AC)
- EXIST WATER RIGHT, CERIFICATE 15128, TO TRANSFER (4.0 AC)
- EXIST WATER RIGHT, CERIFICATE 15128, TO REMAIN (8.0 AC)
- EXIST WATER RIGHT, CERIFICATE 21277, TO TRANSFER (4.4 AC)
- EXIST WATER RIGHT, CERIFICATE 21277, TO REMAIN (15.5 AC)
- TRANSFERRED LOCATION OF WATER RIGHT, CERTIFICATE 14476, (10.0 AC)
- TRANSFERRED LOCATION OF WATER RIGHT, CERTIFICATE 15128, (4.0 AC)
- TRANSFERRED LOCATION OF WATER RIGHT, CERTIFICATE 21277, (4.4 AC)

APPLICATION TO TRANSFER WATER RIGHT

Point of Diversion and Place of Use

UNDER


Application No.	23661	18805	21277
	19275	14869	15128
	18137	13782	14476
		Permit No.	Certificate No.

IN THE NAME OF

Sandra L. Moritz

August 12, 2005

SCALE: 1" = 1320'

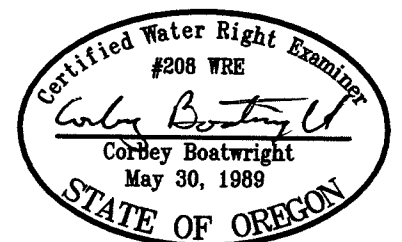

NOTE: This map is not intended to provide legal dimensions or locations of property ownership lines.

EXPIRES 12-31-05

T-1077.2