


TIN, RIOE, WM

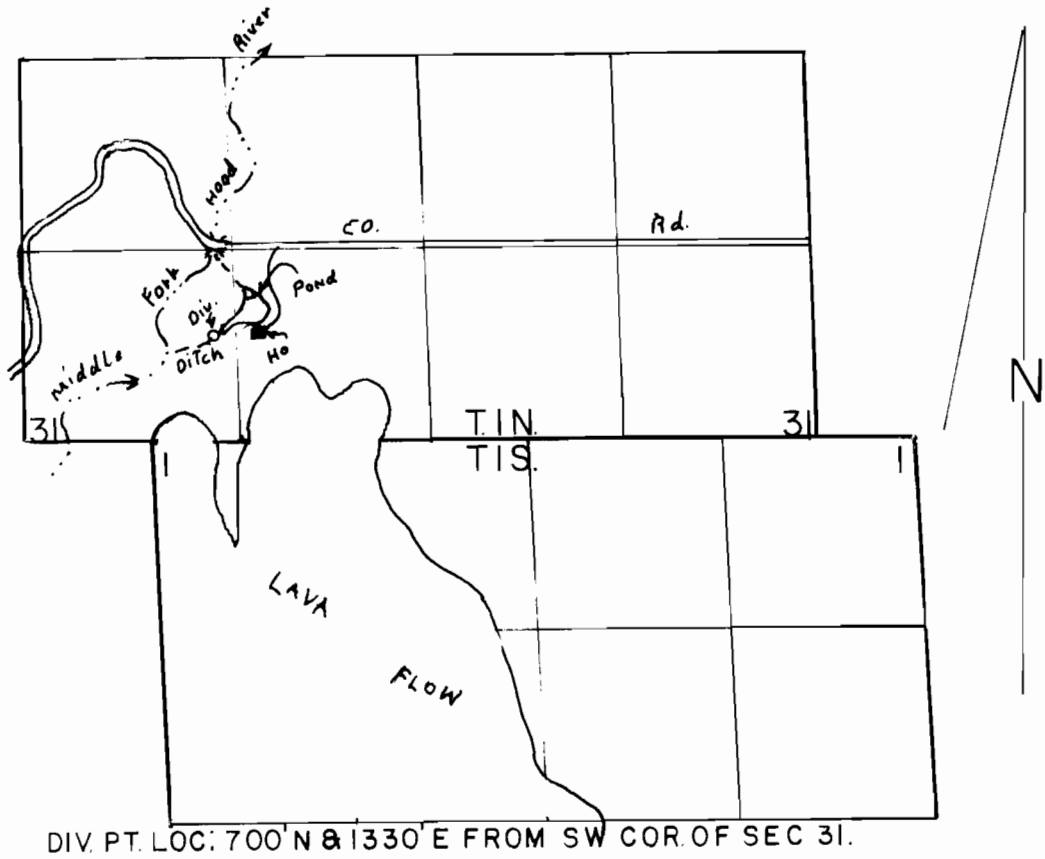

DIV. PT. LOC: 700' N & 1330' E FROM SW COR. OF SEC 31.

SCALE: 1" = 1320'

FINAL PROOF SURVEY UNDER

Application No. R-61200 61201 Permit No. R-11165 50763...
IN NAME OF

JACK R. SANDERS

Surveyed AUG 22 19 95, by R.M. SUTTERFIELD