


T. 5N. R. 29E. W.M.

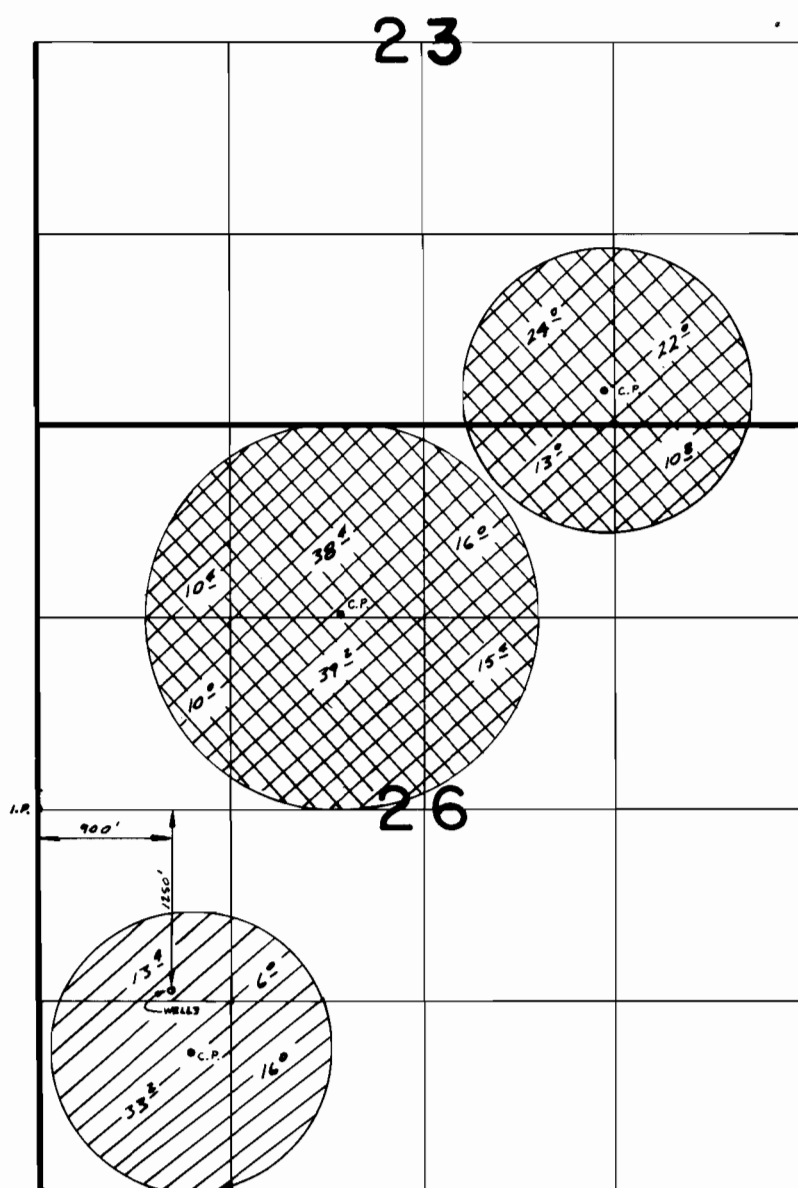

Superseded
9-26-84
GEC

FINAL PROOF SURVEY
UNDER

60172 45108
Application No. G-6910 Permit No. G-5699
IN NAME OF



L. J. & ALICE MARKS

Surveyed 4-3 1978, by R. BARKIN