


WORK COPY

T. 34 S., R. 5 W., W.M.

Sec. 17

SE 1/4 NE 1/4

RECEIVED
APR 18 2005
WATER RESOURCES DEPT
SALEM, OREGON

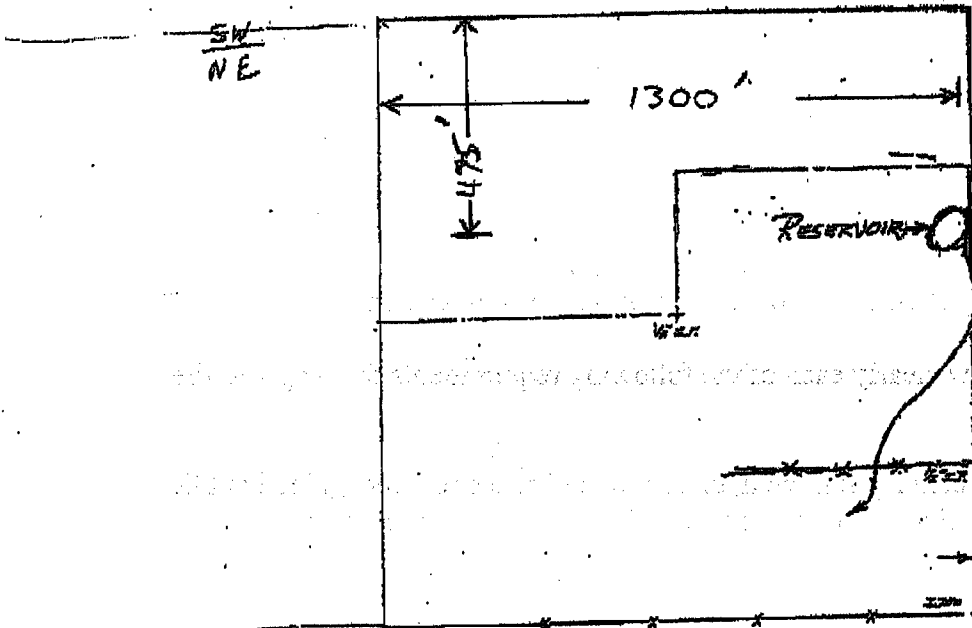

Reservoir is located
475' S.
1300' WE
from quarter
corner NW



Scale 1" = 400'

RECEIVED

OCT 21 2004

WATER RESOURCES DEPT
SALEM, OREGON

RESERVOIR APPLICATION

FOR WOLFGANG E. NEBMAIER

app # R-86124
Permit # R-14124

By BRS