T.2N., R.12E., W.M.

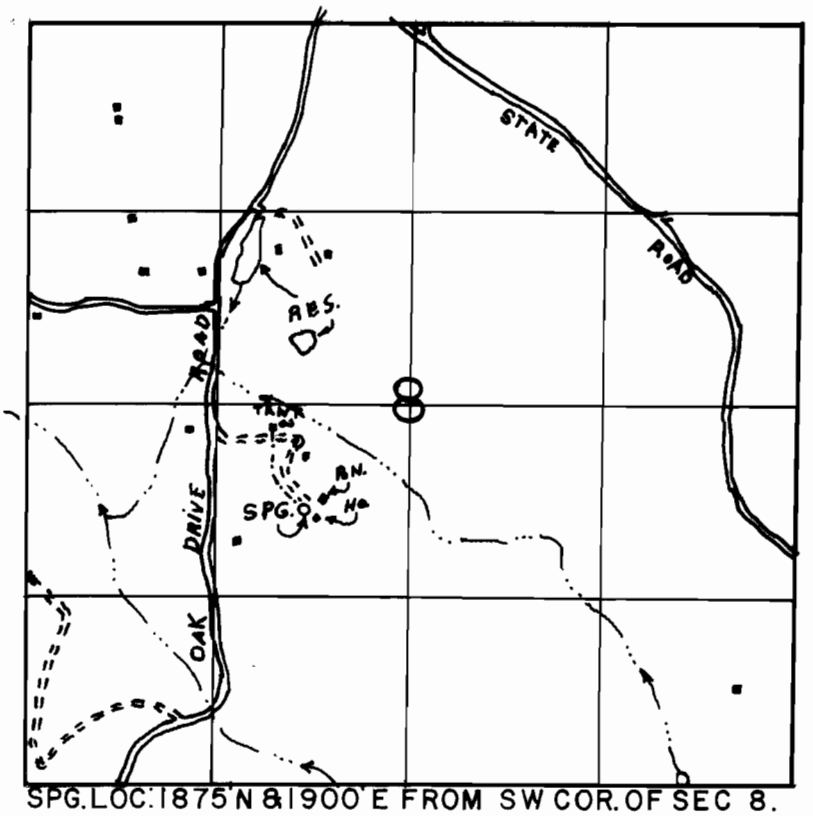

SPG.LOC:1875'N &1900'E FROM SW COR.OF SEC 8.

N

SCALE:1"=1320'

FINAL PROOF SURVEY
UNDER

Application No. 68118 **Permit No.** 48874
IN NAME OF

JOHN C. KASMER

Surveyed APRIL 25 **19** 95, **by** R.M.SUTTERFIELD

PHOTO SURVEY 41065-379-20R 12/19/95 R.M.S.