


T. 1 S., R. 10 E., W. M.

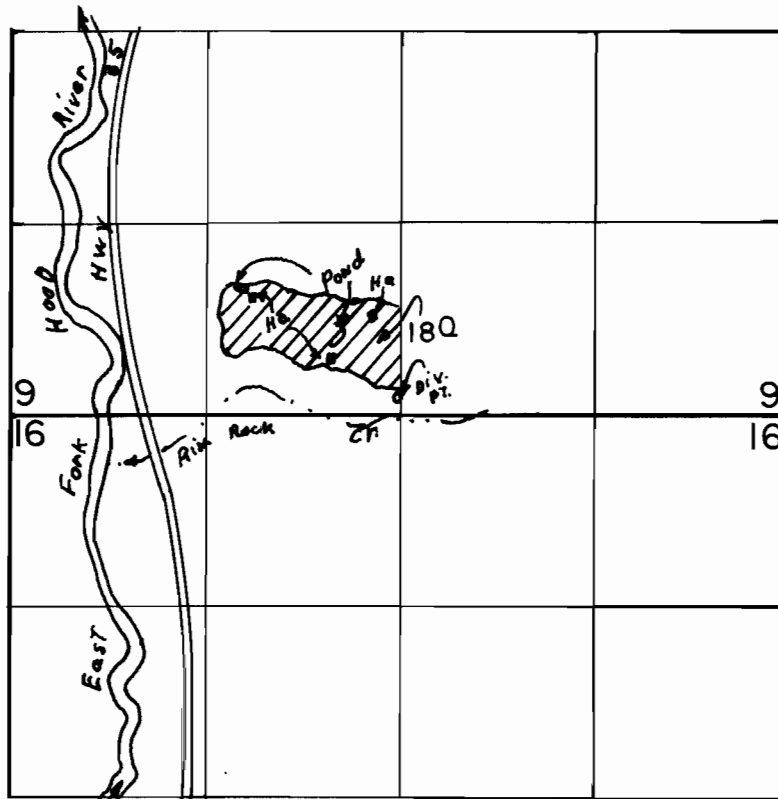

DIV. LOC: 160' N & 10' W FROM 1/4 COR. OF SEC. 9.

SCALE: 1" = 1320'

FINAL PROOF SURVEY UNDER

Application No. 57633 R-58079 Permit No. 43828 R-7781
IN NAME OF

DOUGLAS A. SHARKEY, WILLIAM A. STURMAN & ROBERT T. DANKO.

Surveyed AUG. 23. 1995, by R.M. SUTTERFIELD