


T.1S.,R.10E.,W.M.

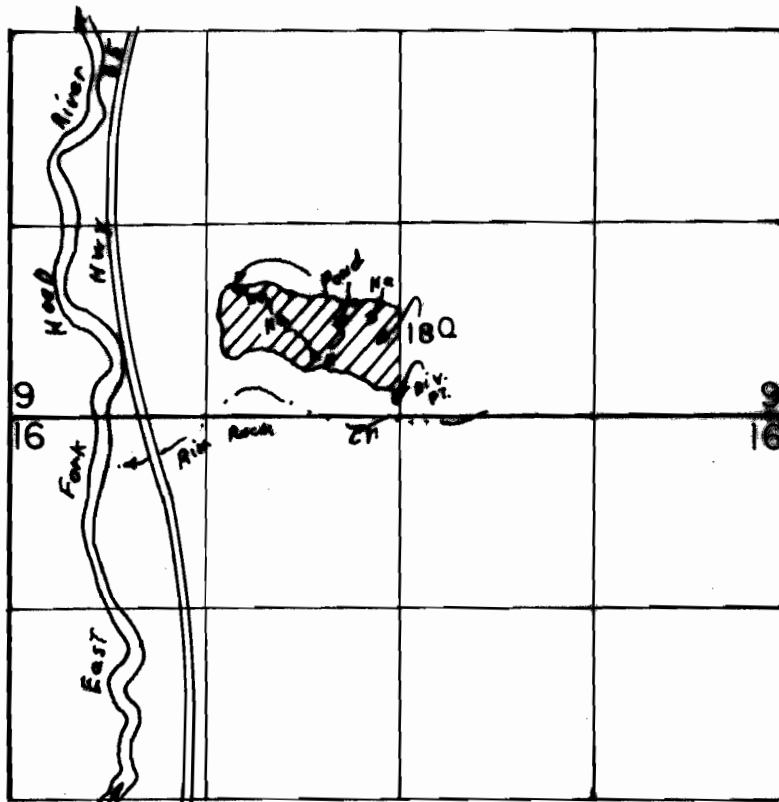

DIV. LOC: 160' N & 10' W FROM 1/4 COR. OF SEC 9.

SCALE: 1" = 1320'

FINAL PROOF SURVEY
UNDER

Application No. 57633 R-58079 Permit No. 43828 R-7781
IN NAME OF

DOUGLAS A. SHARKEY, WILLIAM A. STURMAN & ROBERT T. DANKO.

Surveyed AUG 23, 1995, by R.M. SUTTERFIELD