


T.3S.,R.10E.,W.M.

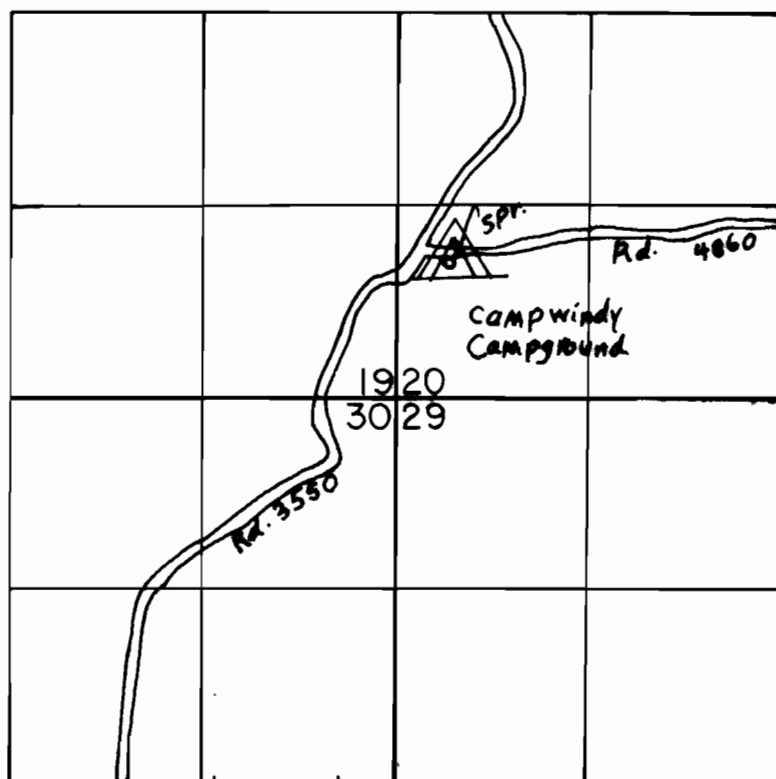

SPR. LOC. 930' N & 350' E FROM SW COR. OF SEC. 20.

SCALE: 1" = 1320'

FINAL PROOF SURVEY UNDER

Application No. 62242. Permit No. 48719
IN NAME OF

UNITED STATES MT. HOOD NATIONAL FOREST

Surveyed AUG. 30. 1995, by R.M. SUTTERFIELD