

RECEIVED
 SEP 29 1986
 APR 25 1986

WATER RESOURCES DEPT. SALEM, OREGON
 WATER RESOURCES DEPT. SALEM, OREGON



JUL 2 1986

WATER RESOURCES DEPT. SALEM, OREGON

JAN 8 1987

RECEIVED

INFORMATION PER FIELD INSPECTION REPORT, 7-20-95, by JANE MILLER
 JW 6-3/28/06


T4N., R.28, E.W.M. Pit Well #1 FROM NE CORNER, Section 35

Pit Well #2 - Supp.; 262.5 Ac's.

Pit Well #1 - Supp.; 147.0 Ac's.

Pit Well #2 - Pri.; 2.5 Ac's.

Pit Well #1 - Pri.; 3.8 Ac's.

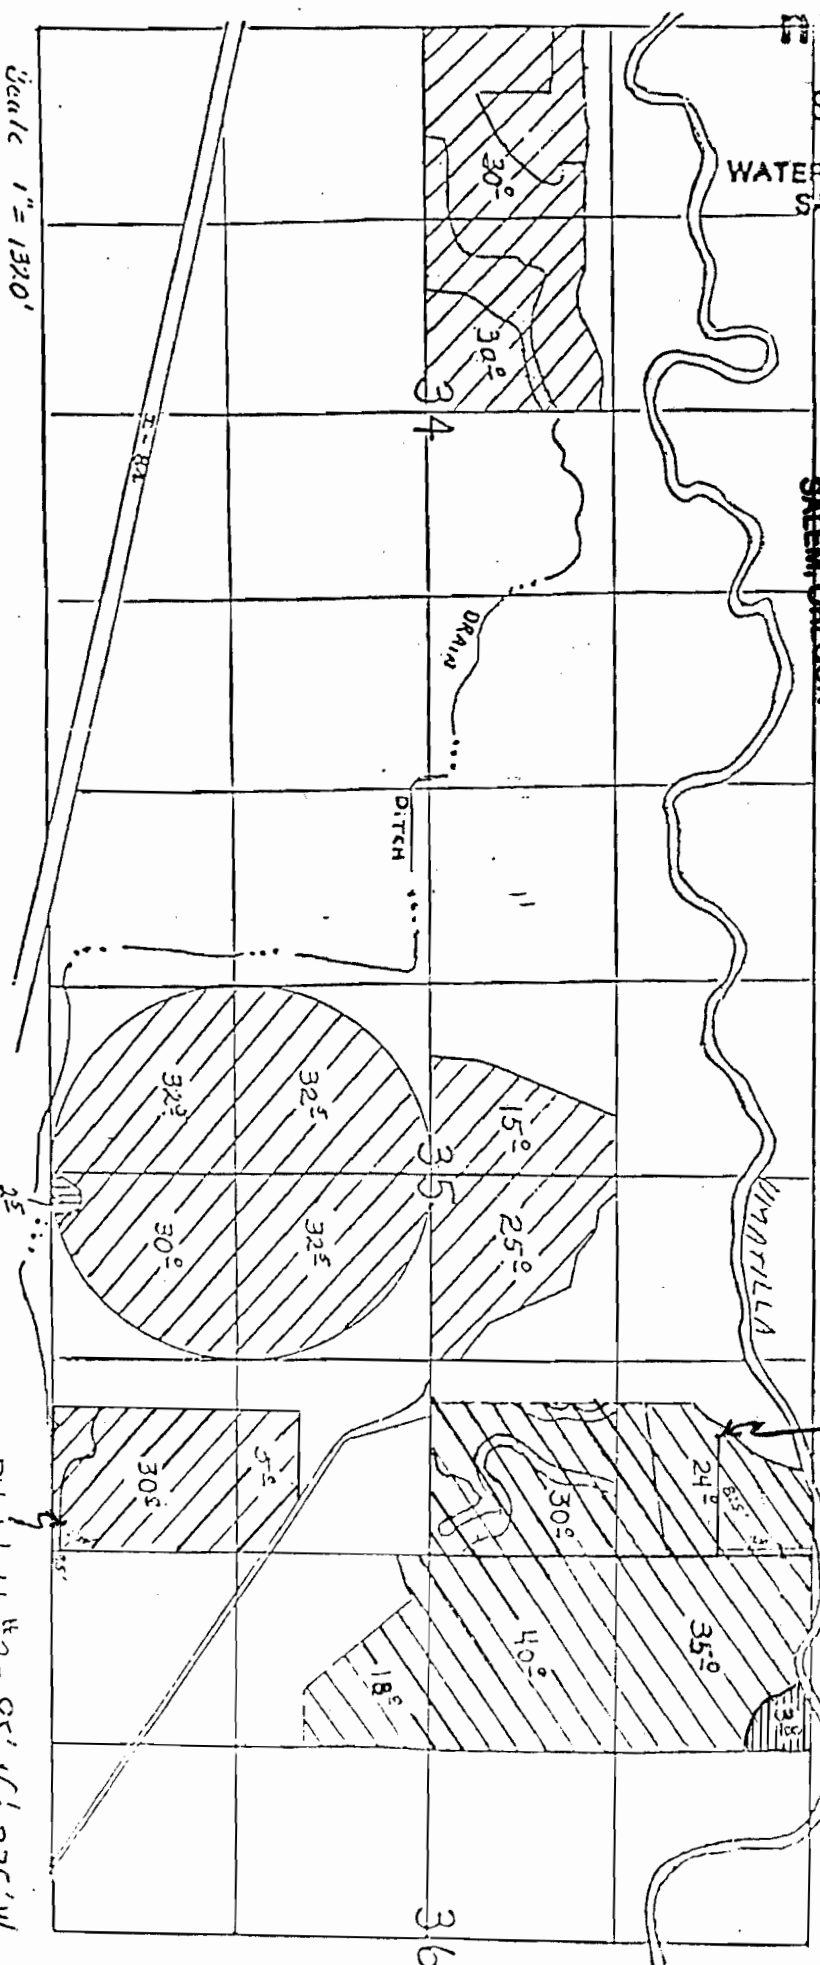

Scale 1" = 1320'

Application No. G-114 S8
 Permit No. G10709

Pit Well #2 - 85' N & 275' W
 FROM SE CORNER,
 Section 35