


T. 2 N., R. 30 E., W. M.

2 IN 30 E
4" = 1 MILE

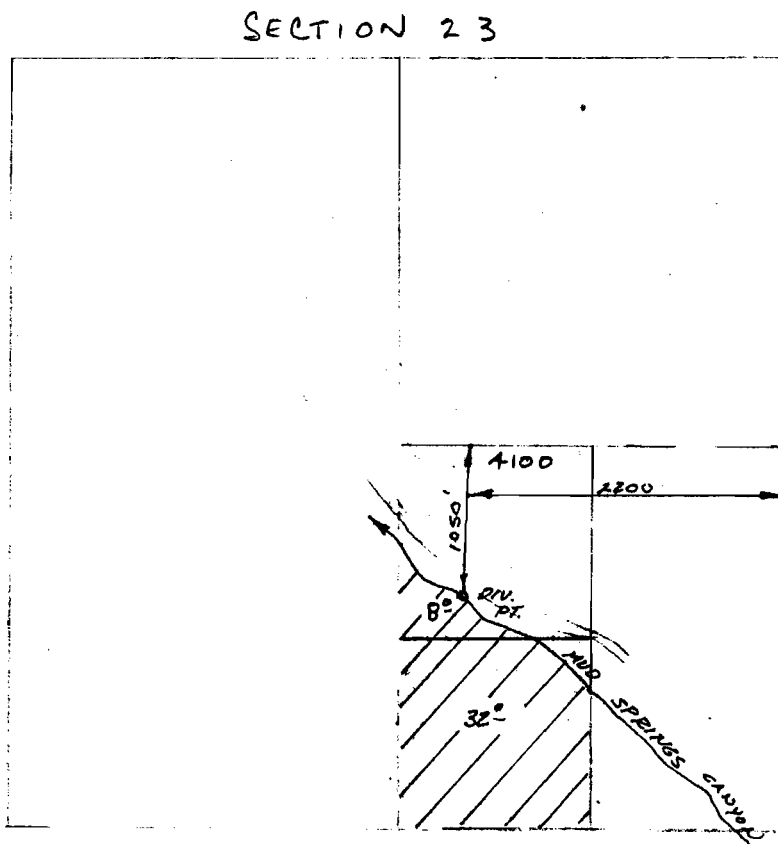

Application No. 61458
Permit No. 45799

SCALE 4" = 1 MILE
TAX LOT 4100 CONTAINS
APPROXIMATELY 77.38 ACRES

This map to be used as
Final Proof Survey map.
Information as reflected by
field inspection report.
JWG 3/30/06

RECEIVED
JUN 15 1981
WATER RESOURCES DEPT
SALEM, OREGON


T. 2 N., R. 30 & 31 E., W.M.

RECEIVED!

MAR 27 1981

WATER RESOURCES DEPT
SALEM, OREGON

MAP FOR LOCATION
OF STOCK USE.

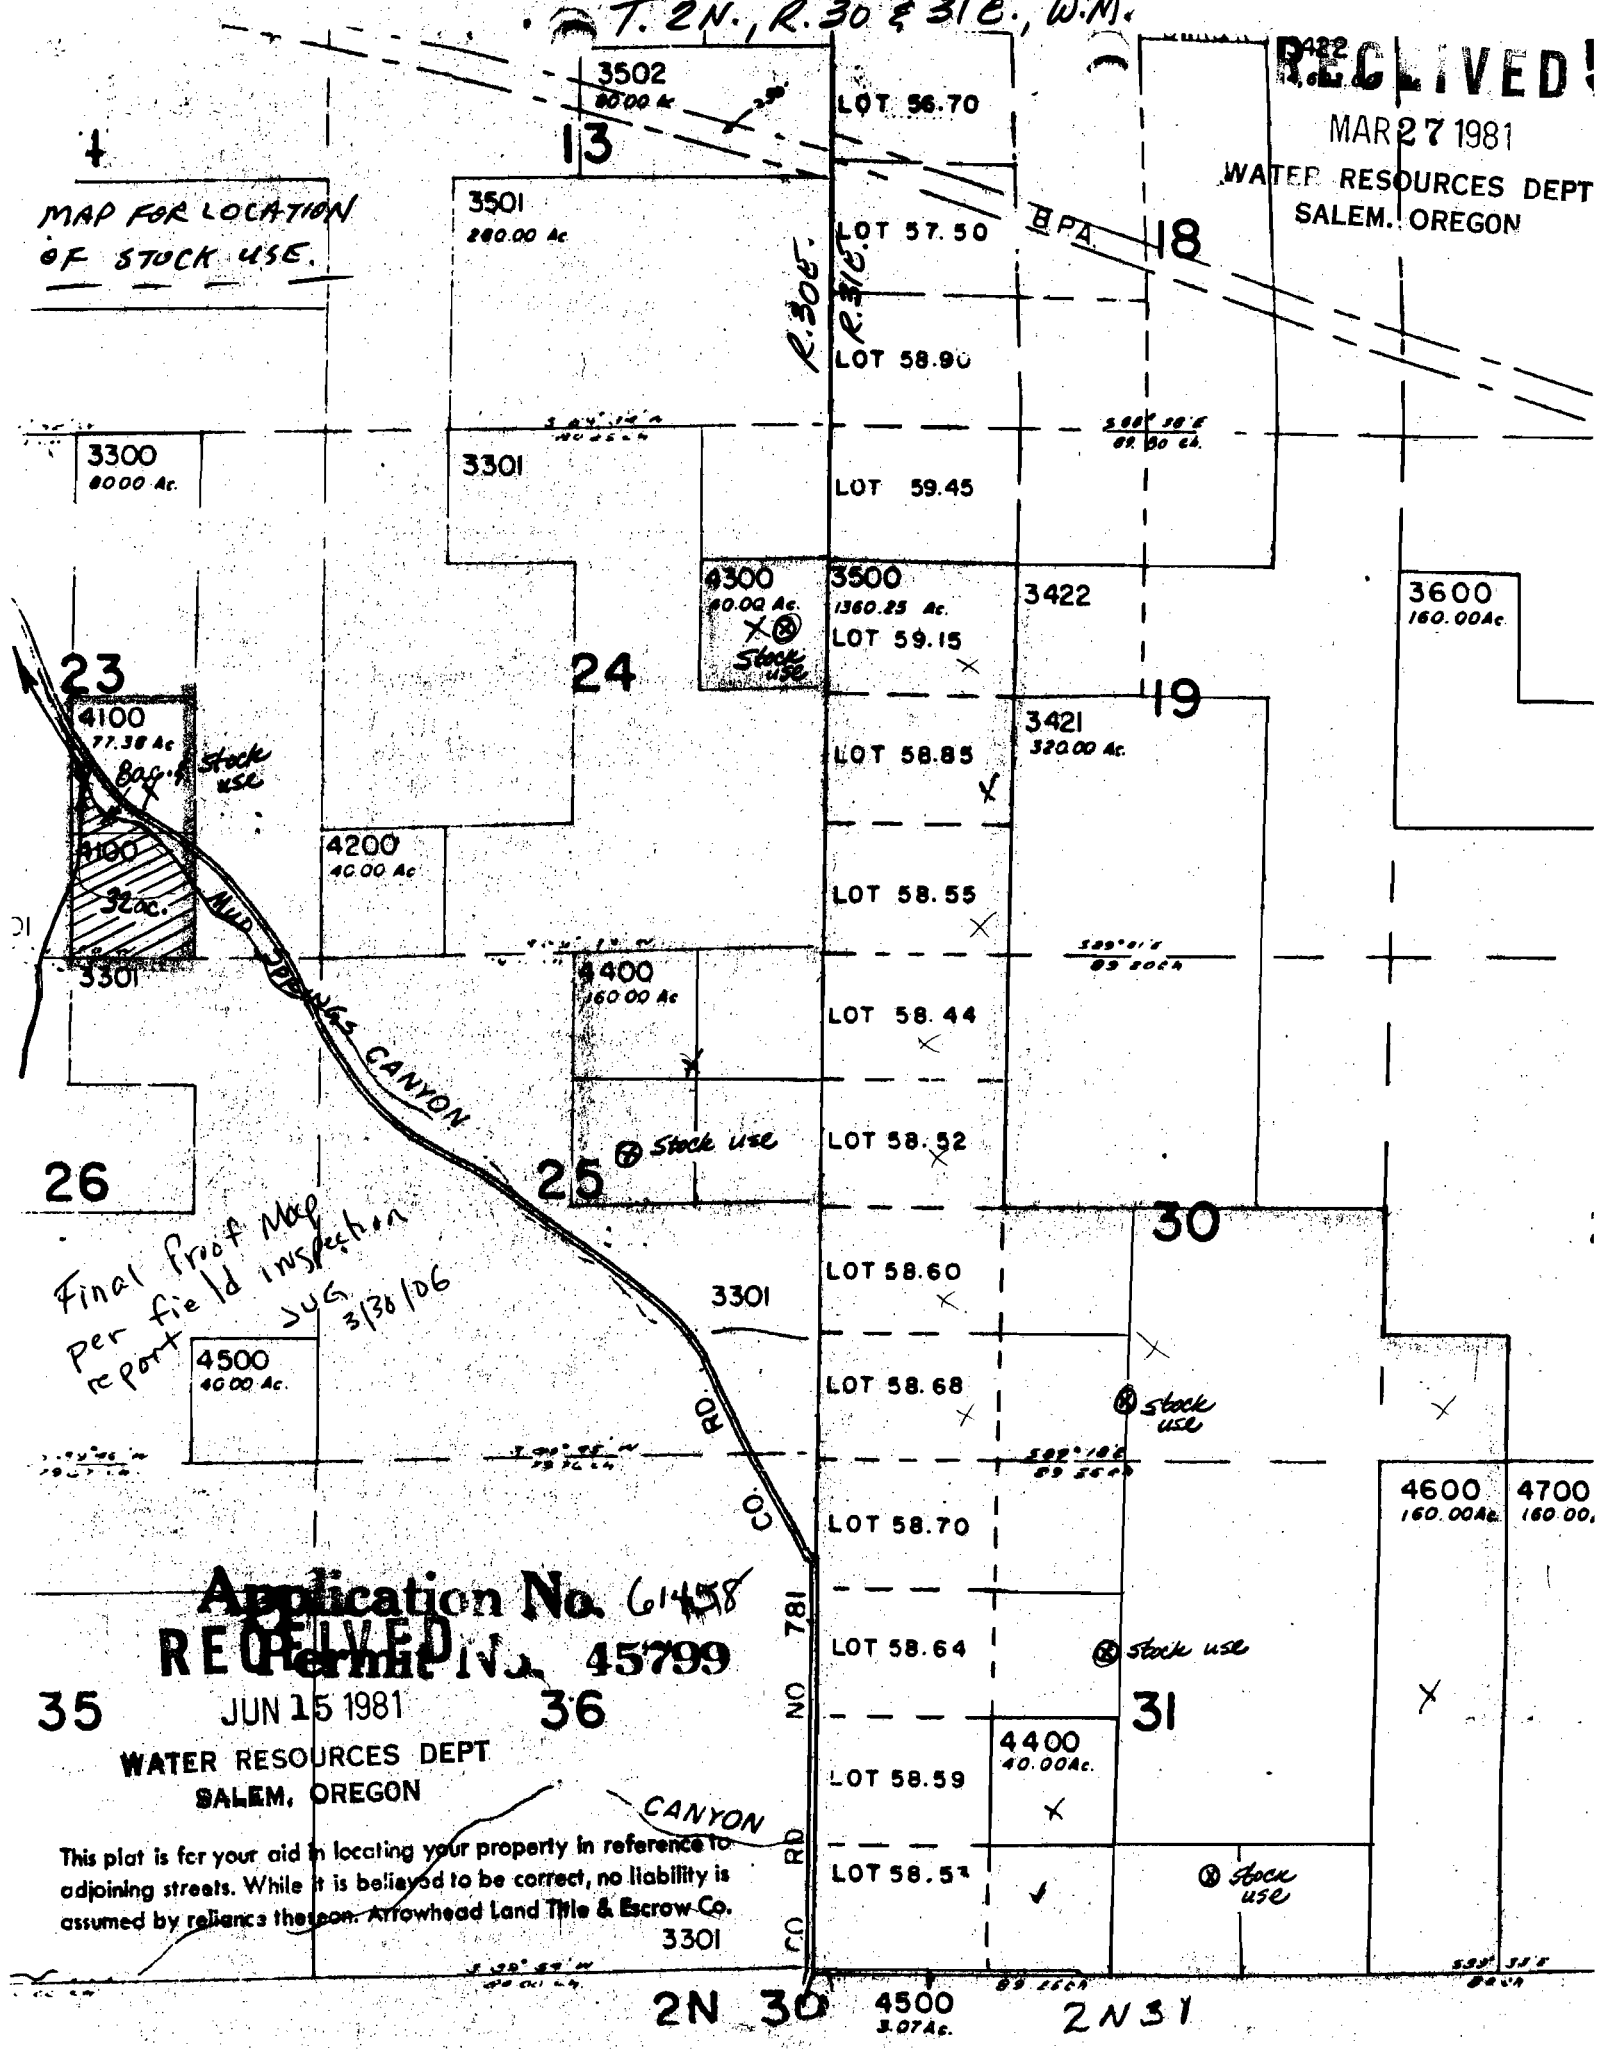

Application No. 61458
RECEIVED Permit No. 45799

JUN 15 1981

WATER RESOURCES DEPT
SALEM, OREGON

This plat is for your aid in locating your property in reference to adjoining streets. While it is believed to be correct, no liability is assumed by reliance thereon. Arrowhead Land Title & Escrow Co.

2N 30

4500
3.07 Ac.

2N 31