


T. 2 N., R. 34 E., W.M.

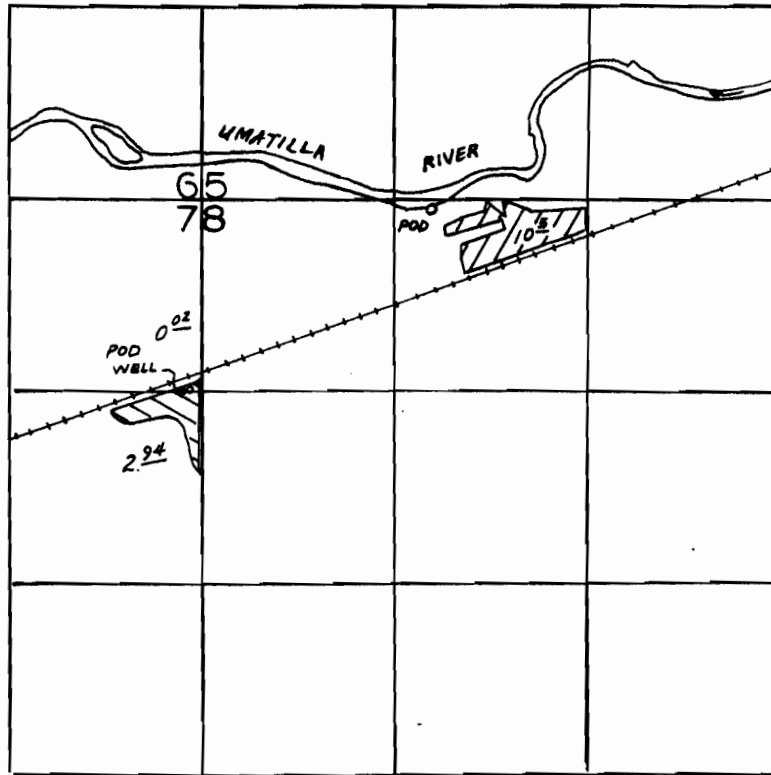

1" = 1320'

POD WELL - 1280' S. AND 100' W. FROM NW COR. SEC. 8.
POD UMATILLA - 50' S. AND 1575' E. FROM NW COR. SEC. 8



FINAL PROOF SURVEY

UNDER

Application No. 63264 Permit No. 47406
G-10650 G-10069
IN NAME OF

CLINTON C. CASE

Surveyed 6-90, 1992, by V. CHURCH