






RECEIVED


AUG - 2 1996

WATER RESOURCES DEPT.  
SALEM, OREGON

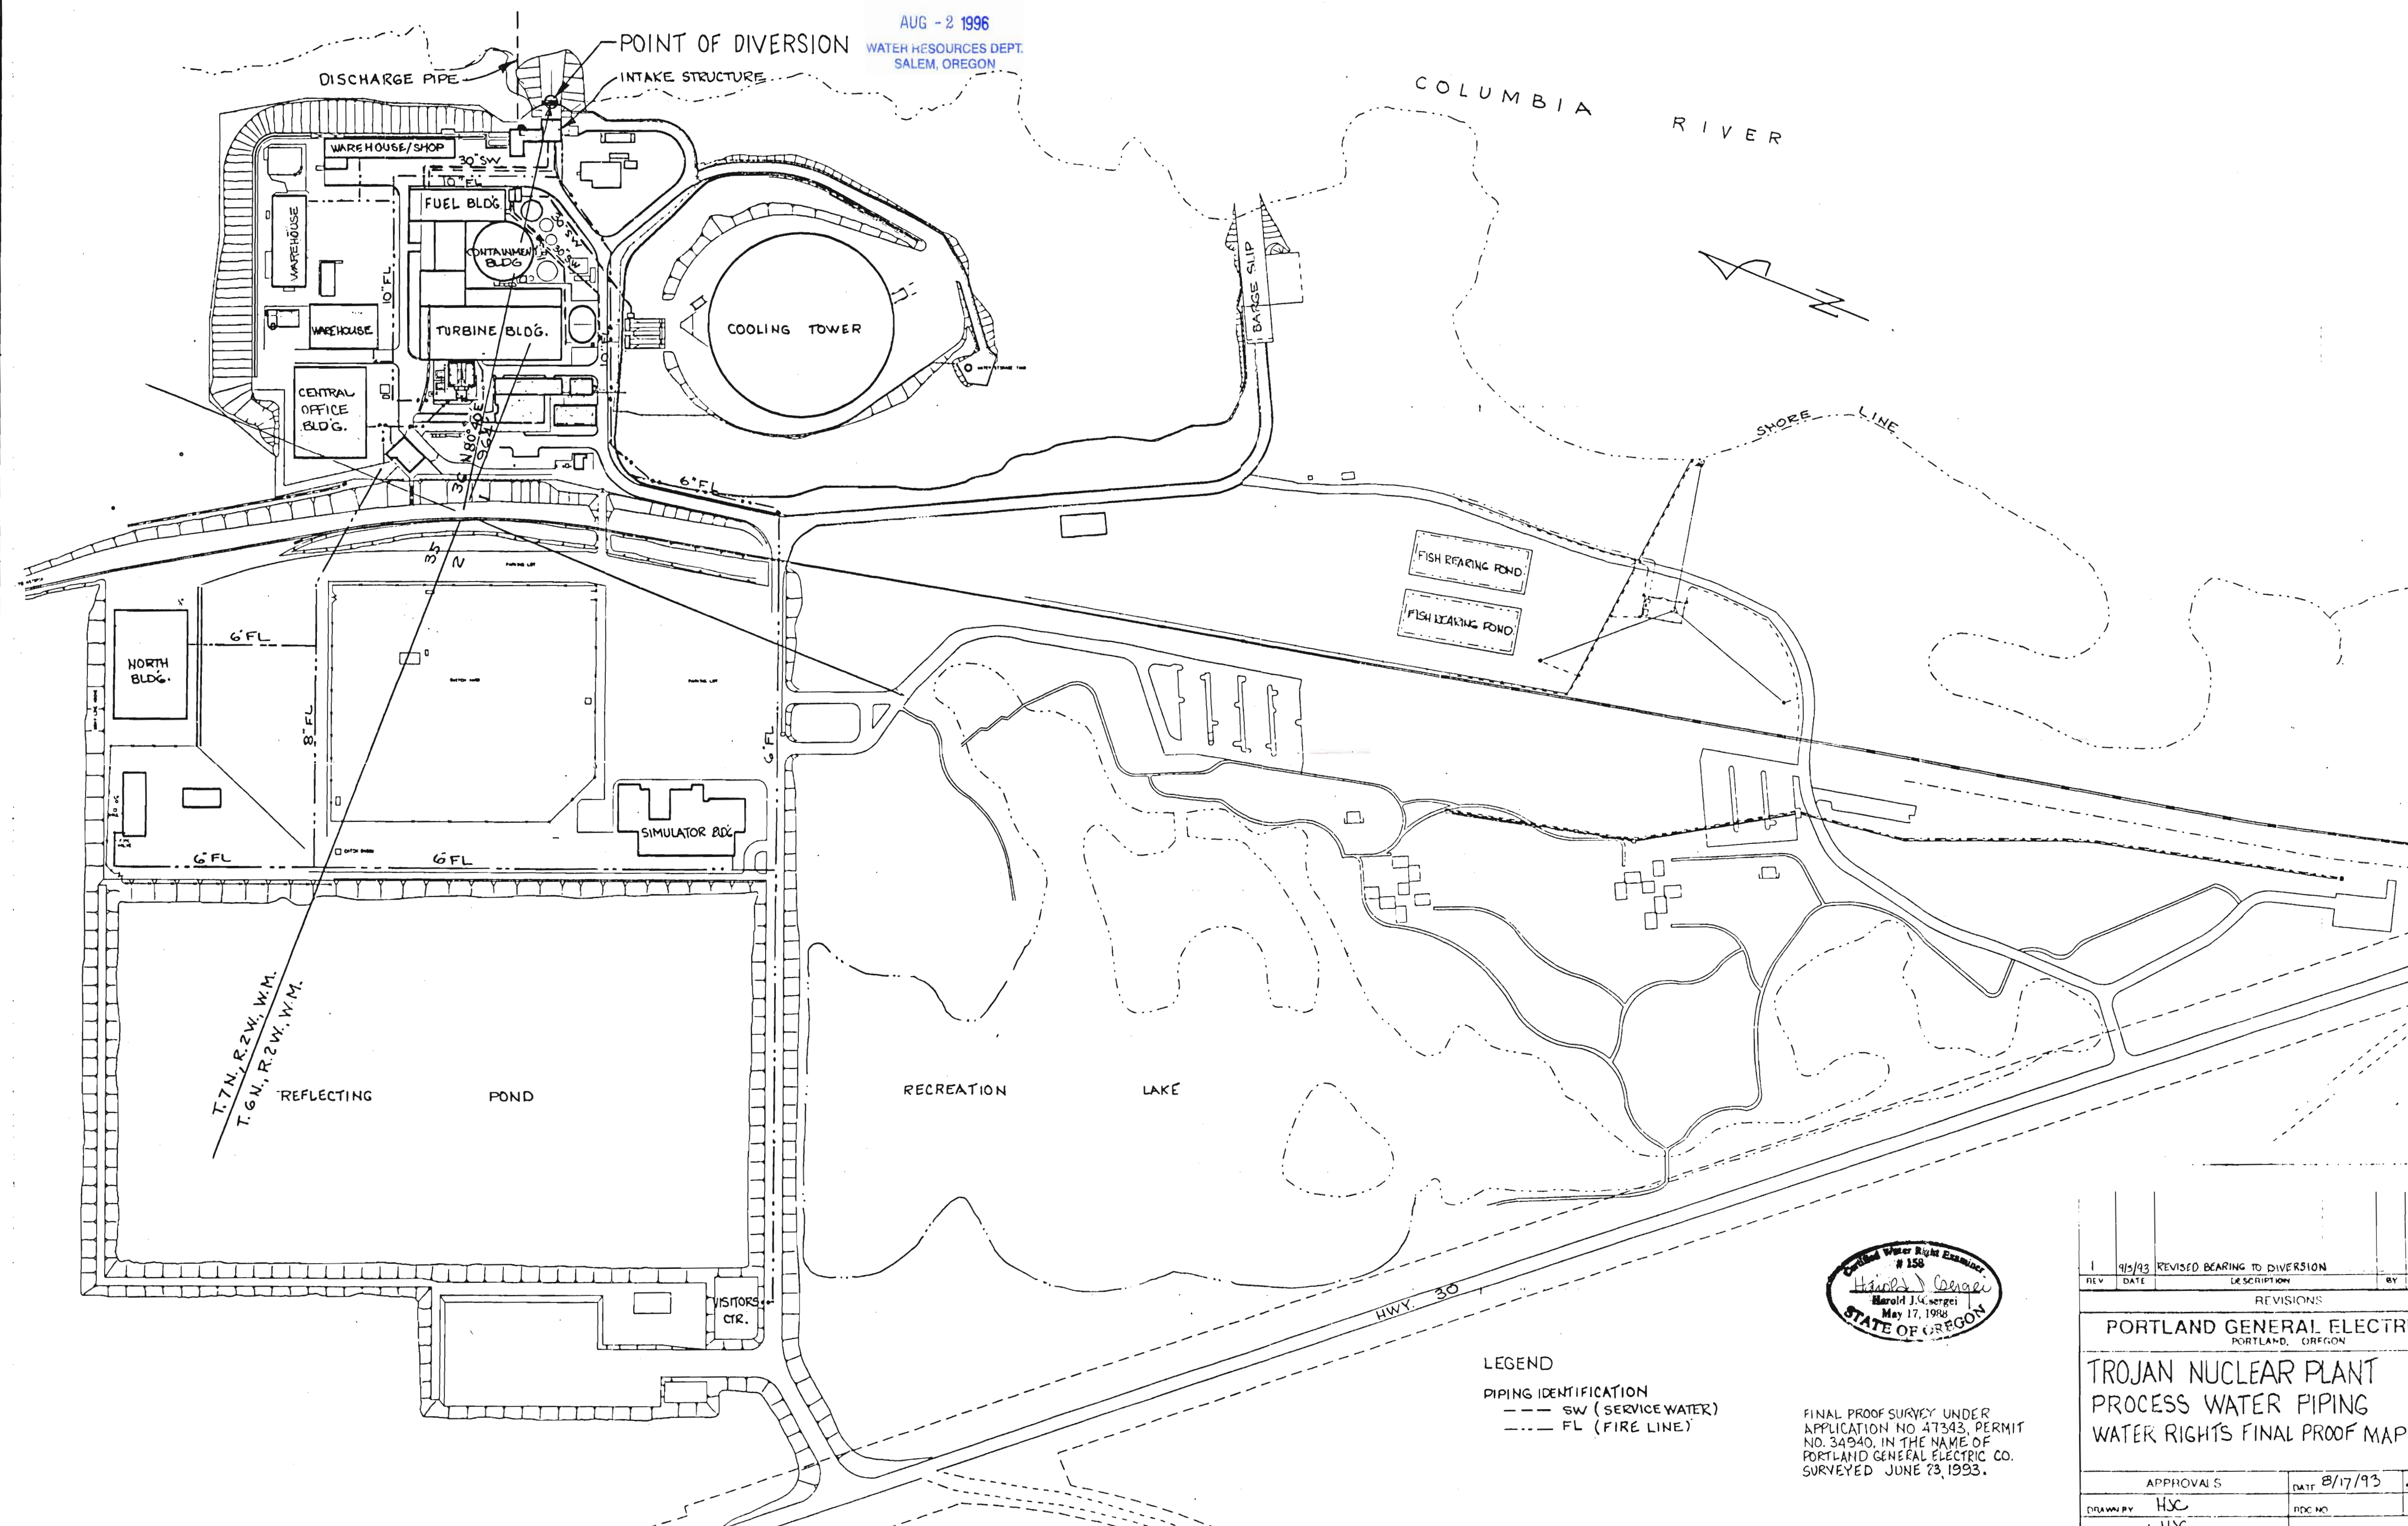

T.7N, R.2W, W.M.  
T.6N, R.2W, W.M.


LEGEND  
 PIPING IDENTIFICATION  
 --- SW (SERVICE WATER)  
 --- FL (FIRE LINE)

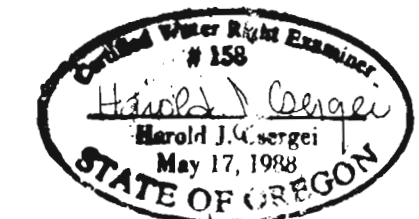


FINAL PROOF SURVEY UNDER  
 APPLICATION NO. 47343, PERMIT  
 NO. 34940, IN THE NAME OF  
 PORTLAND GENERAL ELECTRIC CO.  
 SURVEYED JUNE 23, 1993.

1	9/5/93	REVISED BEARING TO DIVERSION	HSC	GMH
REV	DATE	DESCRIPTION	BY	APPD
REVISIONS				
PORTLAND GENERAL ELECTRIC CO. PORTLAND, OREGON				
TROJAN NUCLEAR PLANT PROCESS WATER PIPING WATER RIGHTS FINAL PROOF MAP				
APPROVALS		DATE 8/17/93	SCALE 1"=200'	
DRAWN BY HSC	CHKD BY	APPD BY		
ENGINEER HSC	DRAWING NO.	REV.		
APPD. <i>George H. Johnson</i>		D-10578	1	



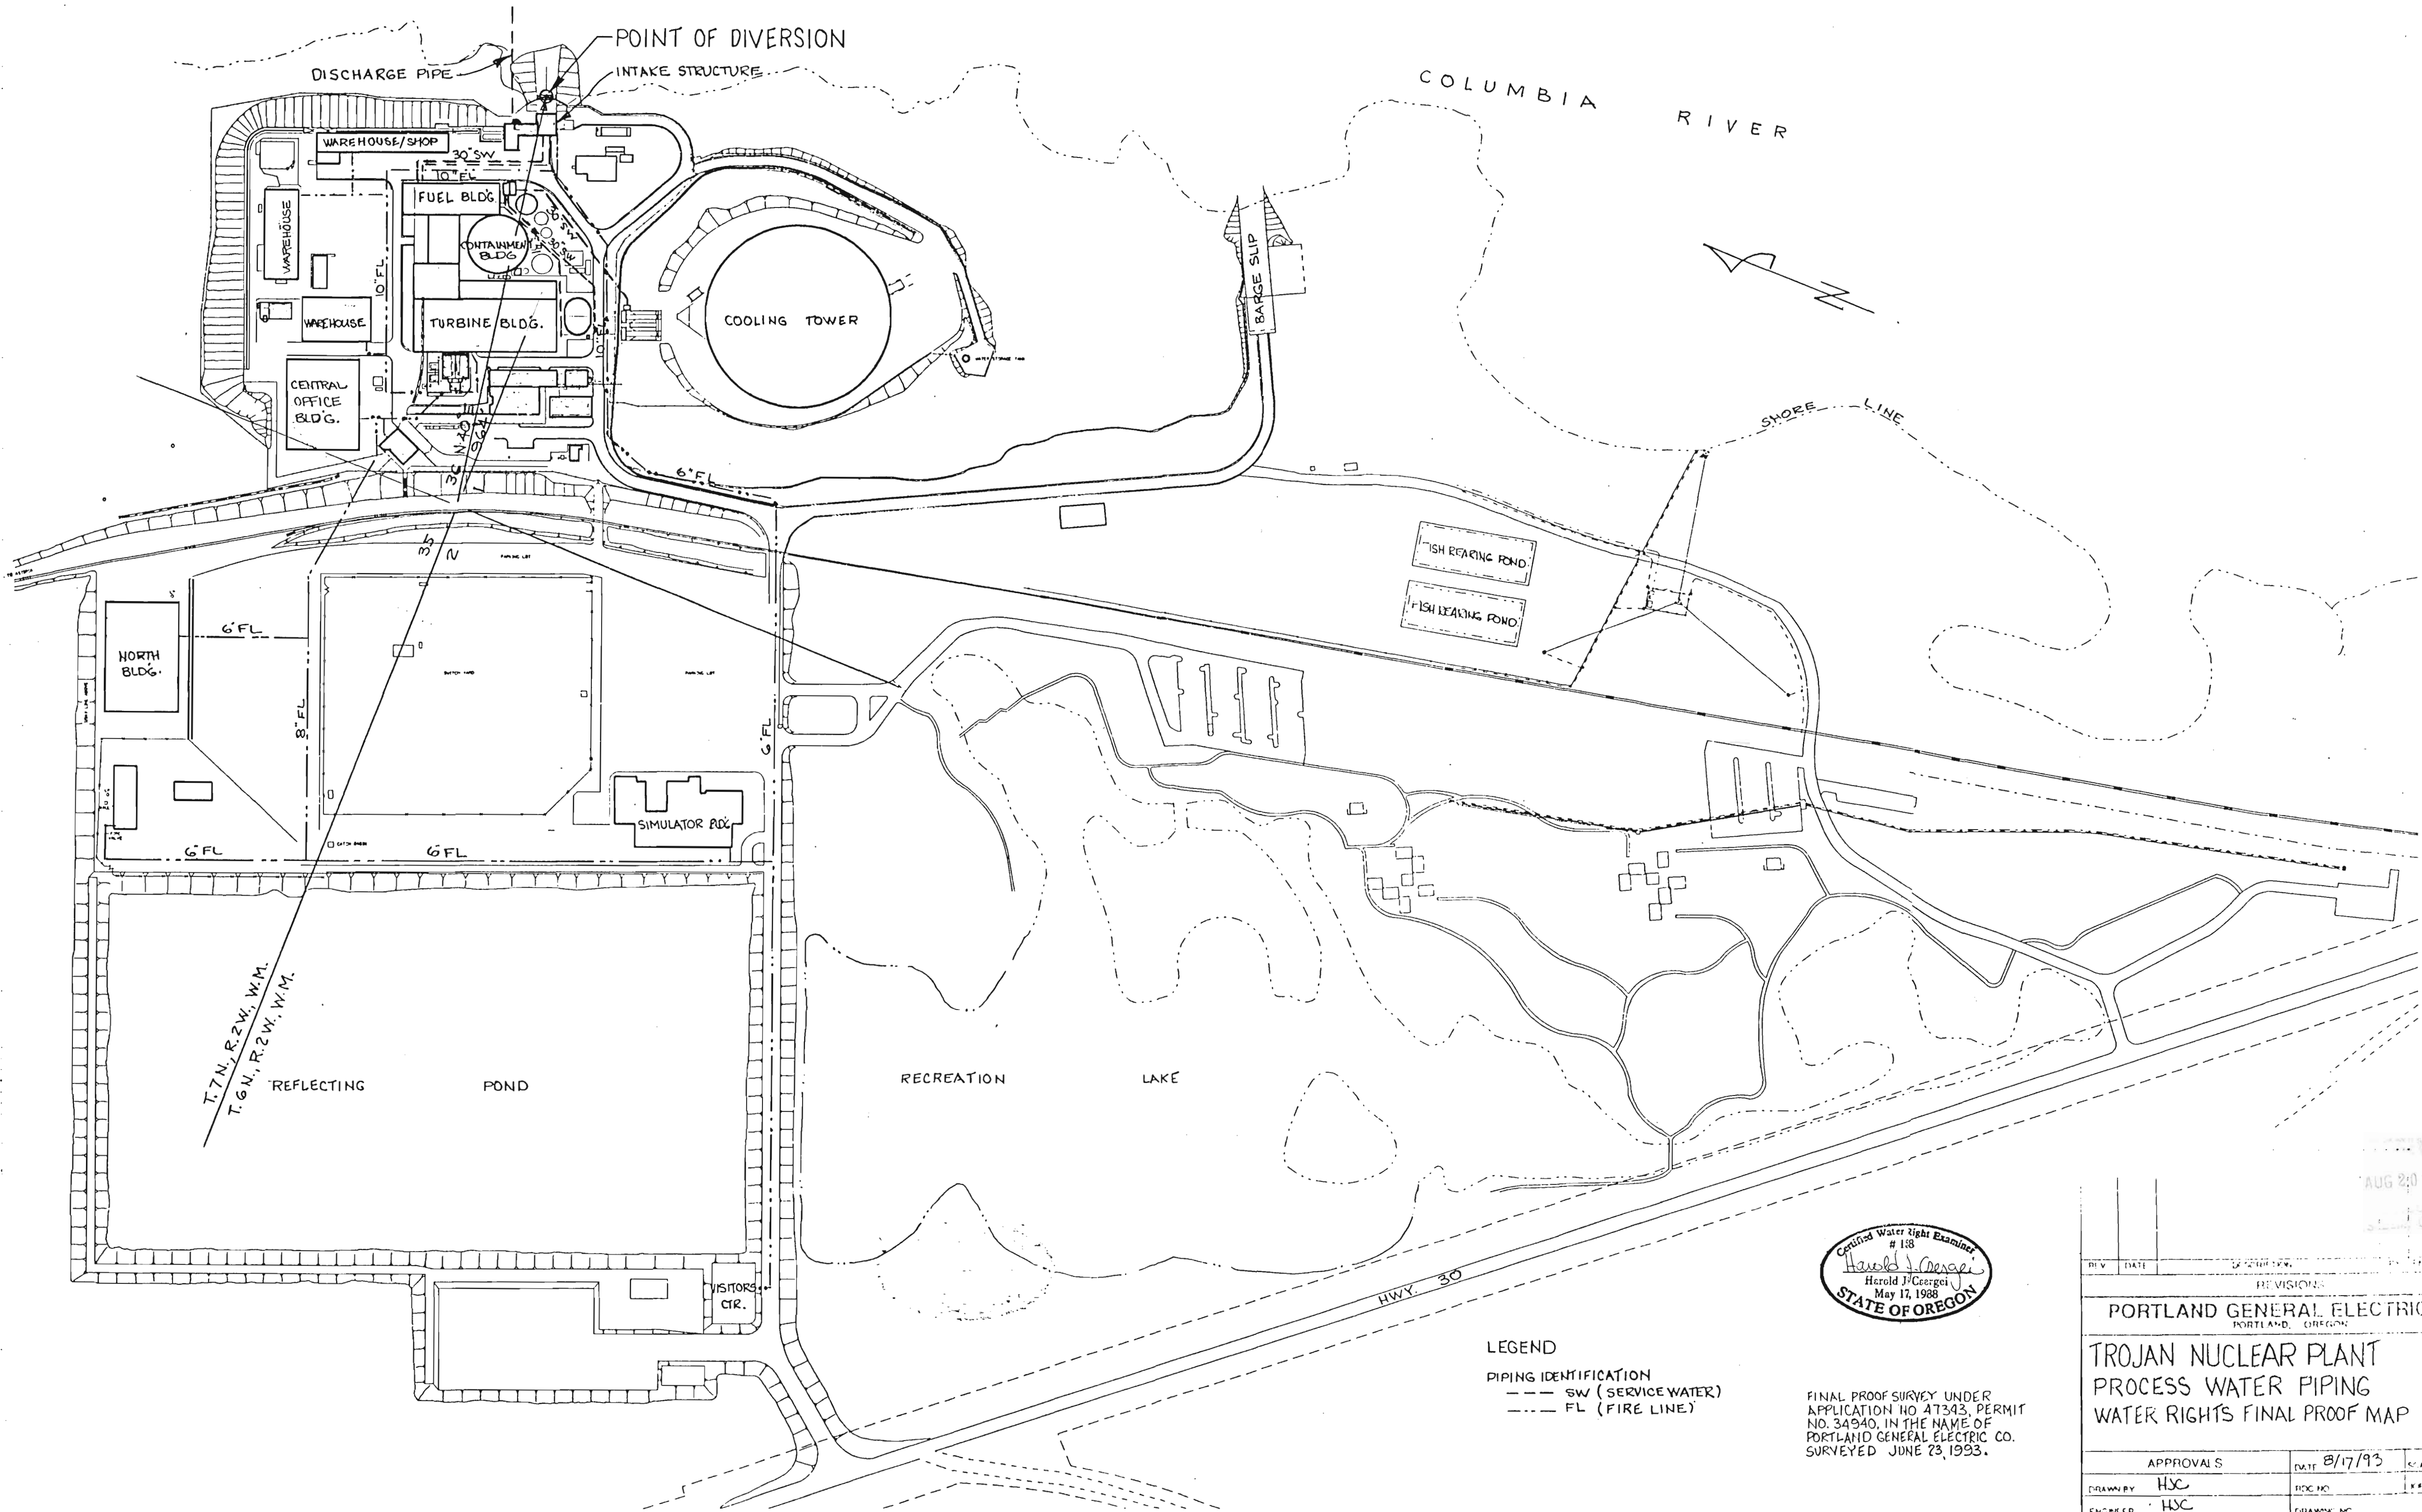

LEGEND  
 PIPING IDENTIFICATION  
 --- SW (SERVICE WATER)  
 - - - FL (FIRE LINE)

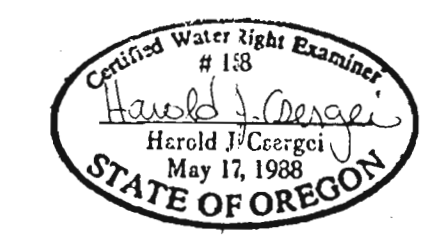

FINAL PROOF SURVEY UNDER  
 APPLICATION NO. 47343, PERMIT  
 NO. 34940, IN THE NAME OF  
 PORTLAND GENERAL ELECTRIC CO.  
 SURVEYED JUNE 23, 1993.

AUG 20 1993 PORTLAND, OREGON		
REVISIONS		
PORTLAND GENERAL ELECTRIC CO. PORTLAND, OREGON		
<b>TROJAN NUCLEAR PLANT          PROCESS WATER PIPING          WATER RIGHTS FINAL PROOF MAP</b>		
APPROVALS	DATE 8/17/93	SCALE 1"=200'
DRAWN BY HSC	DWG. NO.	REV. NO.
ENGINEER HSC	DRAWING NO.	REV.
SUPV. ADM. George Hutchinson	D-10578	0