

WORK COPY

T19 S, R29 E, WM

U.S.F.S.

(N 89°47'W)


R 29 E

R 30 E

RECEIVED

SEP 21 2005

WATER RESOURCES DEPT
SALEM, OREGON

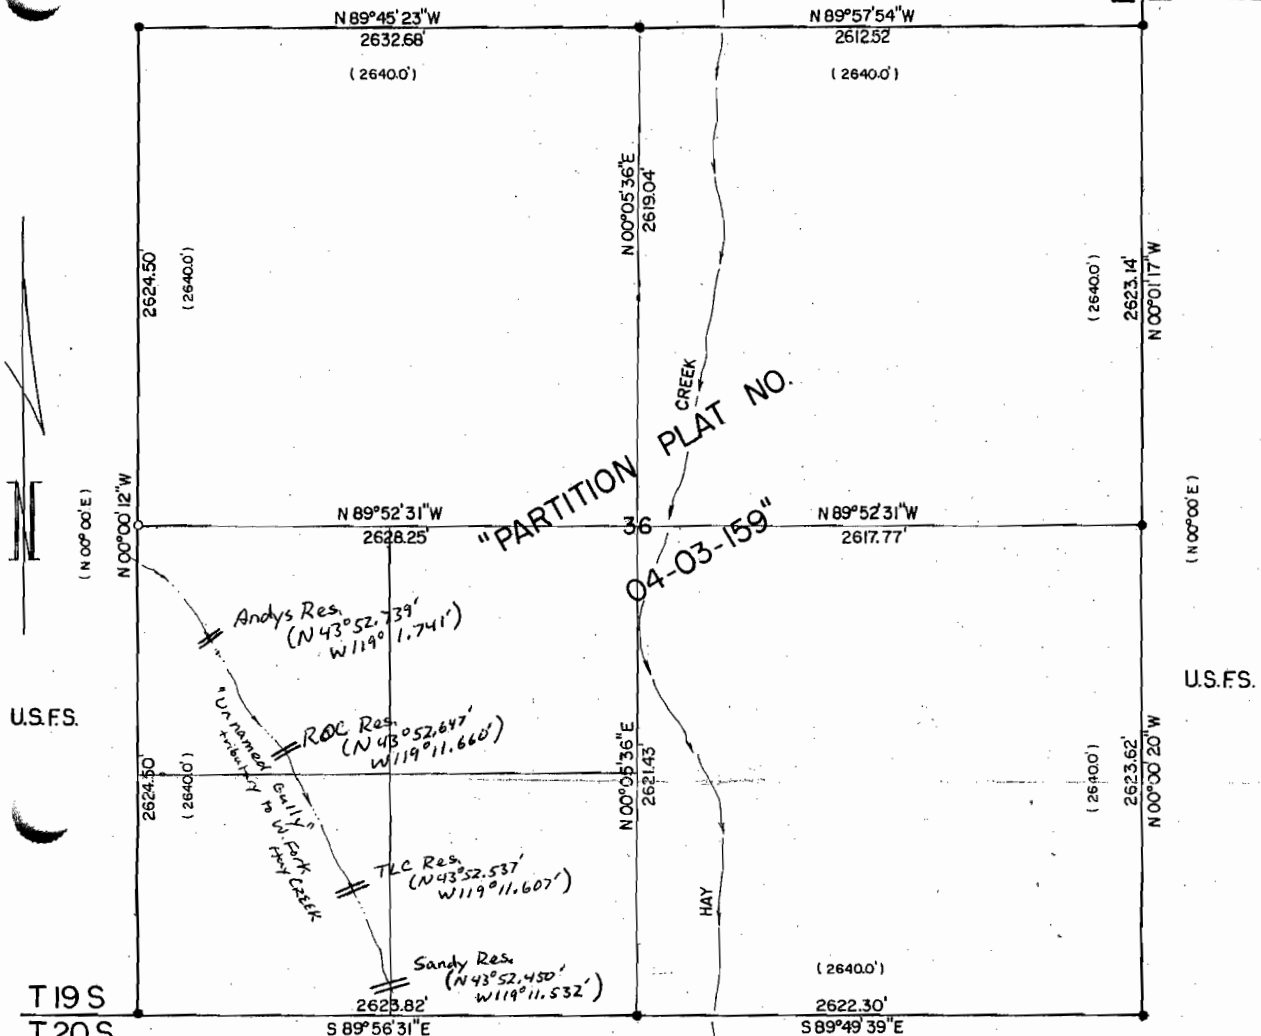

U.S.F.S.

U.S.F.S.

T19 S
T20 S

TAX LOT 70A

(S 90°00'E)

B.L.M.

NARRATIVE

1. This property boundary survey was done at the request of Scott Campbell.
2. Bearings are based on solar observations.
3. Previous survey of record - The G.L.O. survey done by James P. Currin & William H. Odell under contract no. 348, dated January 1, 1880.
4. For further information see "Harney County Corner Restoration Records".

LEGEND

- 1880 G.L.O. corners found and monumented with 3-1/4" alum. caps.
- 1880 G.L.O. corner not found. Set a 3-1/4" alum. cap at the proportioned location.
- () 1880 G.L.O. data of record.

ANDYS RESERVOIR
LOCATED FROM CENTER SECT 36
600 ft SOUTH
2244 ft WEST

RECORDED AS HARNEY
COUNTY SURVEY NO. 928

Date: 06-02-2004

By: Chris T. Palmer H.O.S.

2pp no R 86421
31r no
Permit no
R-11268

REGISTERED PROFESSIONAL LAND SURVEYOR Chris T. Palmer OREGON SEPTEMBER 23, 1977 CHRIS T. PALMER 1288 RENEW 1-1-2005	SCOTT CAMPBELL		
	SURVEY PLAT		
	Scale: 8" = 1 MILE	Date: JUNE 2004	Job: 2174
	Dsn:	M.A. PALMER & SONS, INC. ENGINEERING & SURVEYING 711 Ponderosa Village • Box 61 Burns, Oregon 97720	Sht. No.
Dm: CHRIS			
Ckd:			