


# WORK COPY T19S, R29E, WM

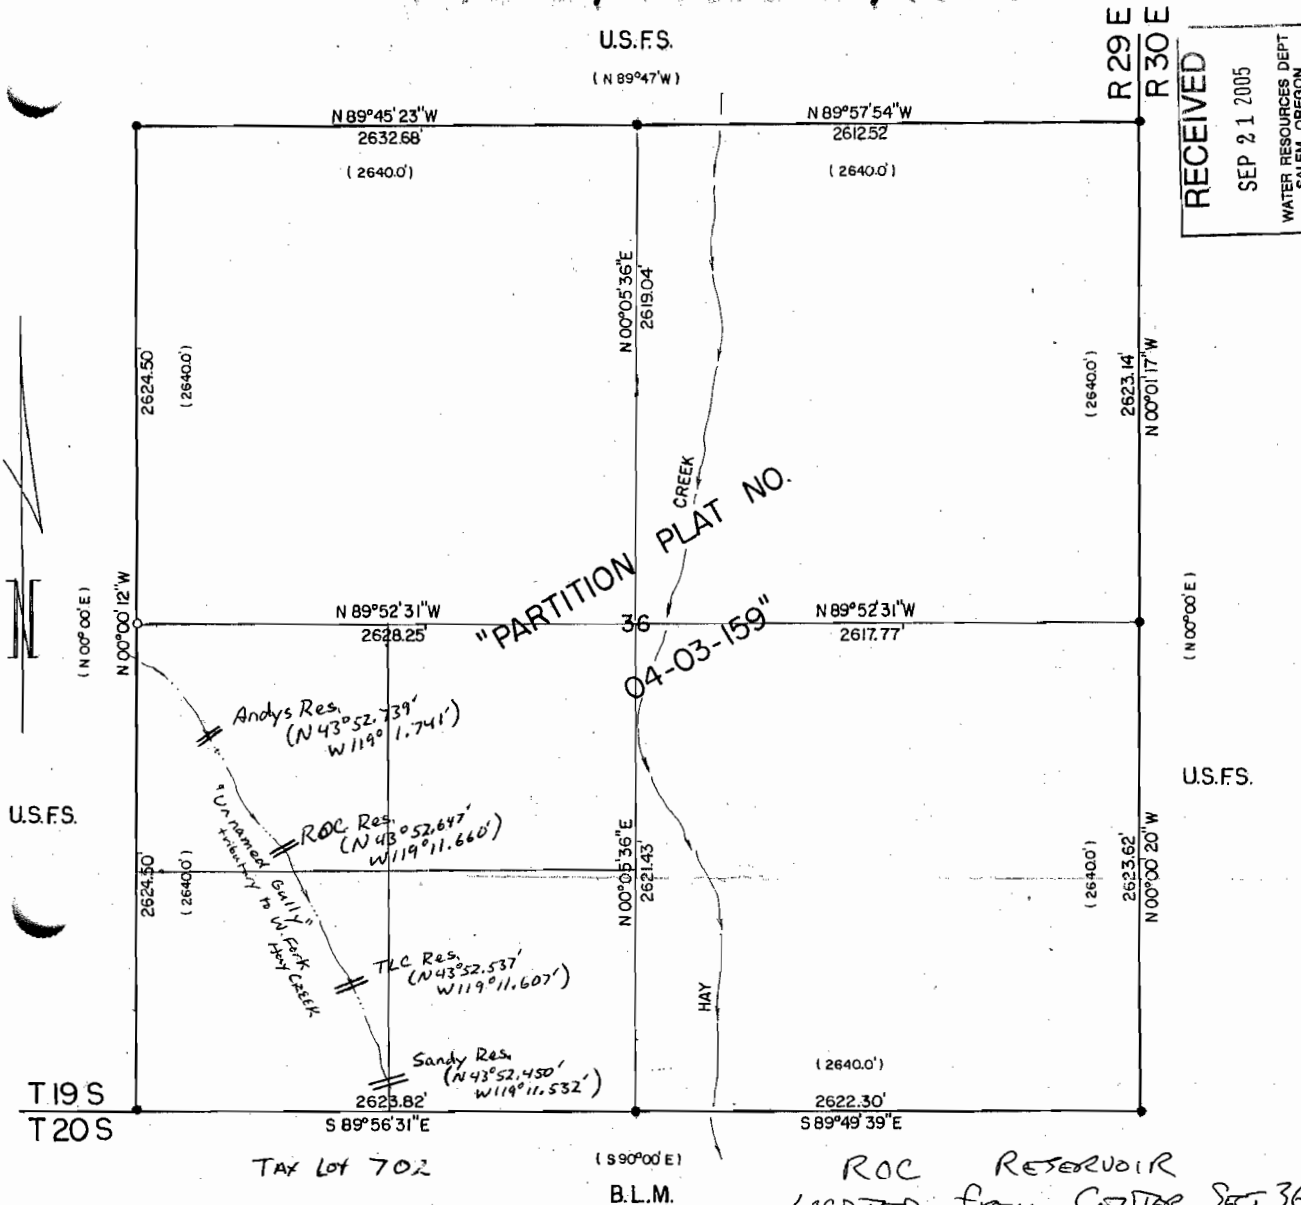

RECEIVED  
SEP 21 2005  
WATER RESOURCES DEPT  
SALEM, OREGON

## NARRATIVE

1. This property boundary survey was done at the request of Scott Campbell.
2. Bearings are based on solar observations.
3. Previous survey of record - The G.L.O. survey done by James P. Currin & William H. Odell under contract no. 348, dated January 1, 1880.
4. For further information see "Harney County Corner Restoration Records".

## LEGEND

- 1880 G.L.O. corners found and monumented with 3-1/4" alum. caps.
- 1880 G.L.O. corner not found. Set a 3-1/4" alum. cap at the proportioned location.
- ( ) 1880 G.L.O. data of record.

ROC Reservoir  
LOCATED from CENTER Sect 36  
1190 ft SOUTH  
1850 ft WEST

RECORDED AS HARNEY,  
COUNTY SURVEY NO. 926

Date: 06-02-2004  
By: City of Harney H.O.S.

apns R-86422

Permit R 14269

|   |                                                 |   |                               |
|---|-------------------------------------------------|---|-------------------------------|
| <b>REGISTERED PROFESSIONAL LAND SURVEYOR</b><br><br><b>OREGON</b><br>SEPTEMBER 23, 1977<br><b>CHRIS T. PALMER</b><br>1288<br><b>RENEW 1-1-2005</b> | <b>SCOTT CAMPBELL</b>                           |   |                               |
|   | <b>SURVEY PLAT</b>                              |   |                               |
|   | Scale: 8" = 1 MILE<br>Dsn:<br>Dm: CHRIS<br>Ckd: | Date: JUNE 2004<br><br>M.A. PALMER & SONS, INC.<br>ENGINEERING & SURVEYING<br>711 Ponderosa Village • Box 61<br>Burns, Oregon 97720 | Job: 2174<br>Sht. No.<br>of 1 |
|   |                                                 |   |                               |