WORK COPY

T19S, R29E, WM

RECEIVED
SEP 21 2005
WATER RESOURCES DEPT
SALEM, OREGON

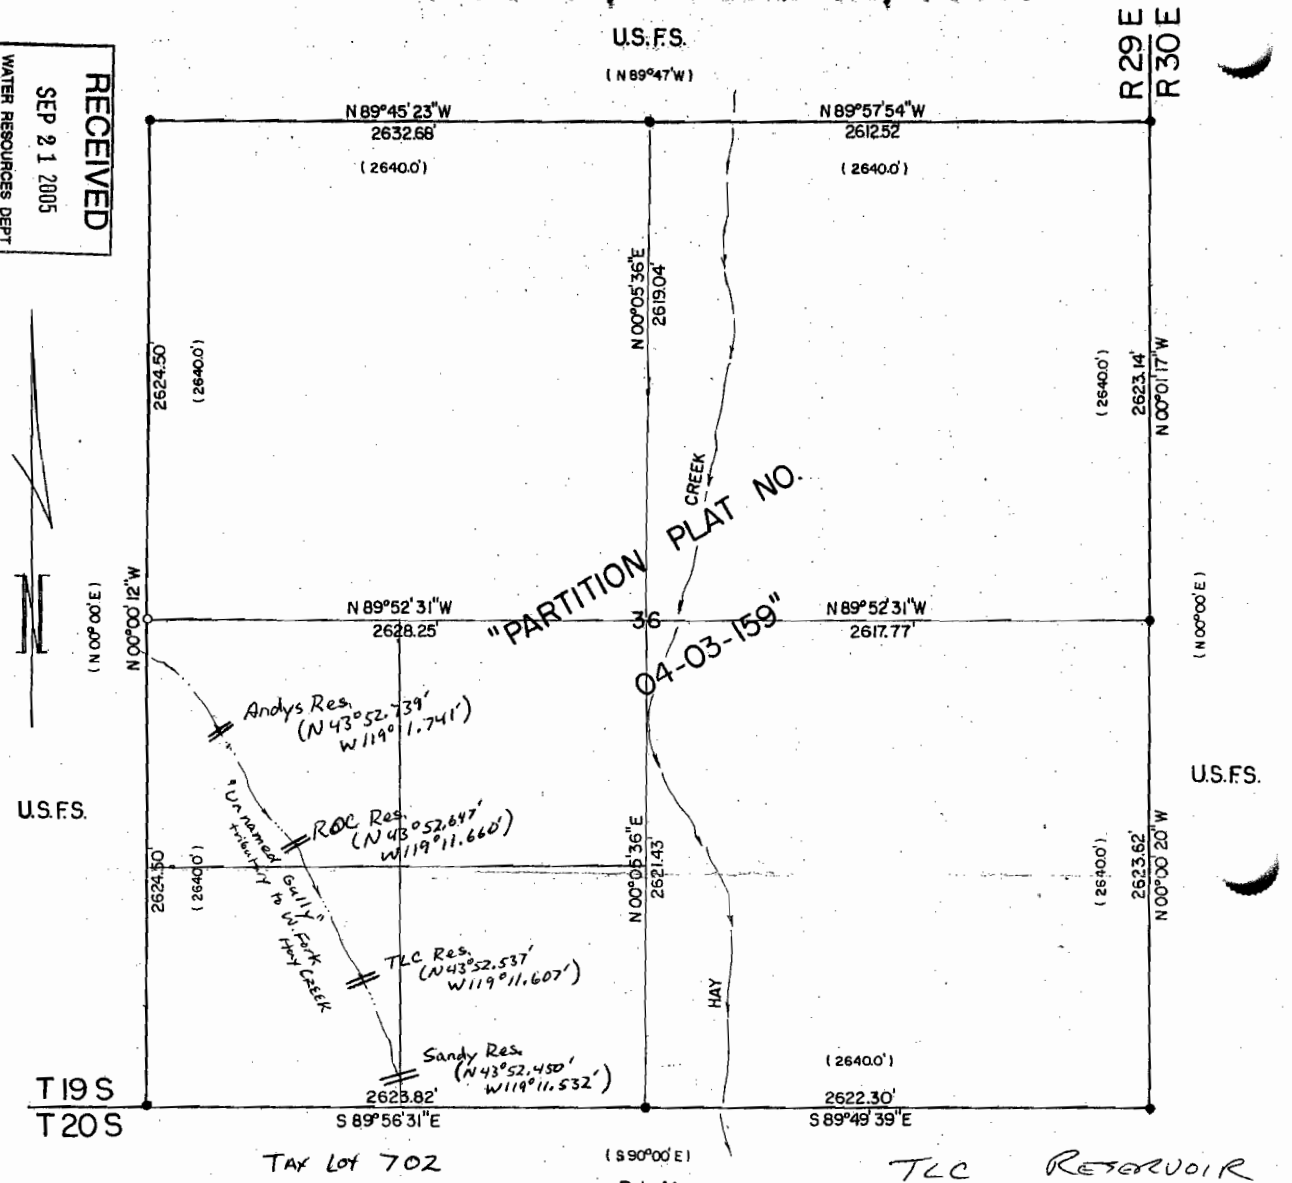

TAX LOT 702

TLC RESERVOIR
LOCATED from CENTER SECT 3
1900 ft SOUTH
1500 ft WEST

NARRATIVE

1. This property boundary survey was done at the request of Scott Campbell.
2. Bearings are based on solar obervations.
3. Previous survey of record - The G.L.O. survey done by James P. Currin & William H. Odell under contract no. 348, dated January 1, 1880.
4. For further information see "Harney County Corner Restoration Records".

RECORDED AS HARNEY COUNTY SURVEY NO. 928
Date: 06-02-2004
By: [signature] H.O.S.

LEGEND

- ● 1880 G.L.O. corners found and monumented with 3-1/4" alum. caps.
- o 1880 G.L.O. corner not found. Set a 3-1/4" alum. cap at the proportioned location.
- ( ) 1880 G.L.O. data of record.

Appno R86423
Permit no R 14270

REGISTERED PROFESSIONAL LAND SURVEYOR
OREGON
SEPTEMBER 23, 1977
CHRIS T. PALMER
1288
RENEW 1-1-2005

SCOTT CAMPBELL

SURVEY PLAT

Scale: 8" = 1 MILE (1:660')	Date: JUNE 2004	Job: 2174
Dsn:	M.A. PALMER & SONS, INC. ENGINEERING & SURVEYING 711 Ponderosa Village • Box 61 Burns, Oregon 97720	Sht. No.
Drn: CHRIS		of 1
Ckd:		