


WORK COPY

T19S, R29E, WM

RECEIVED
SEP 21 2005
WATER RESOURCES DEPT
SALEM, OREGON

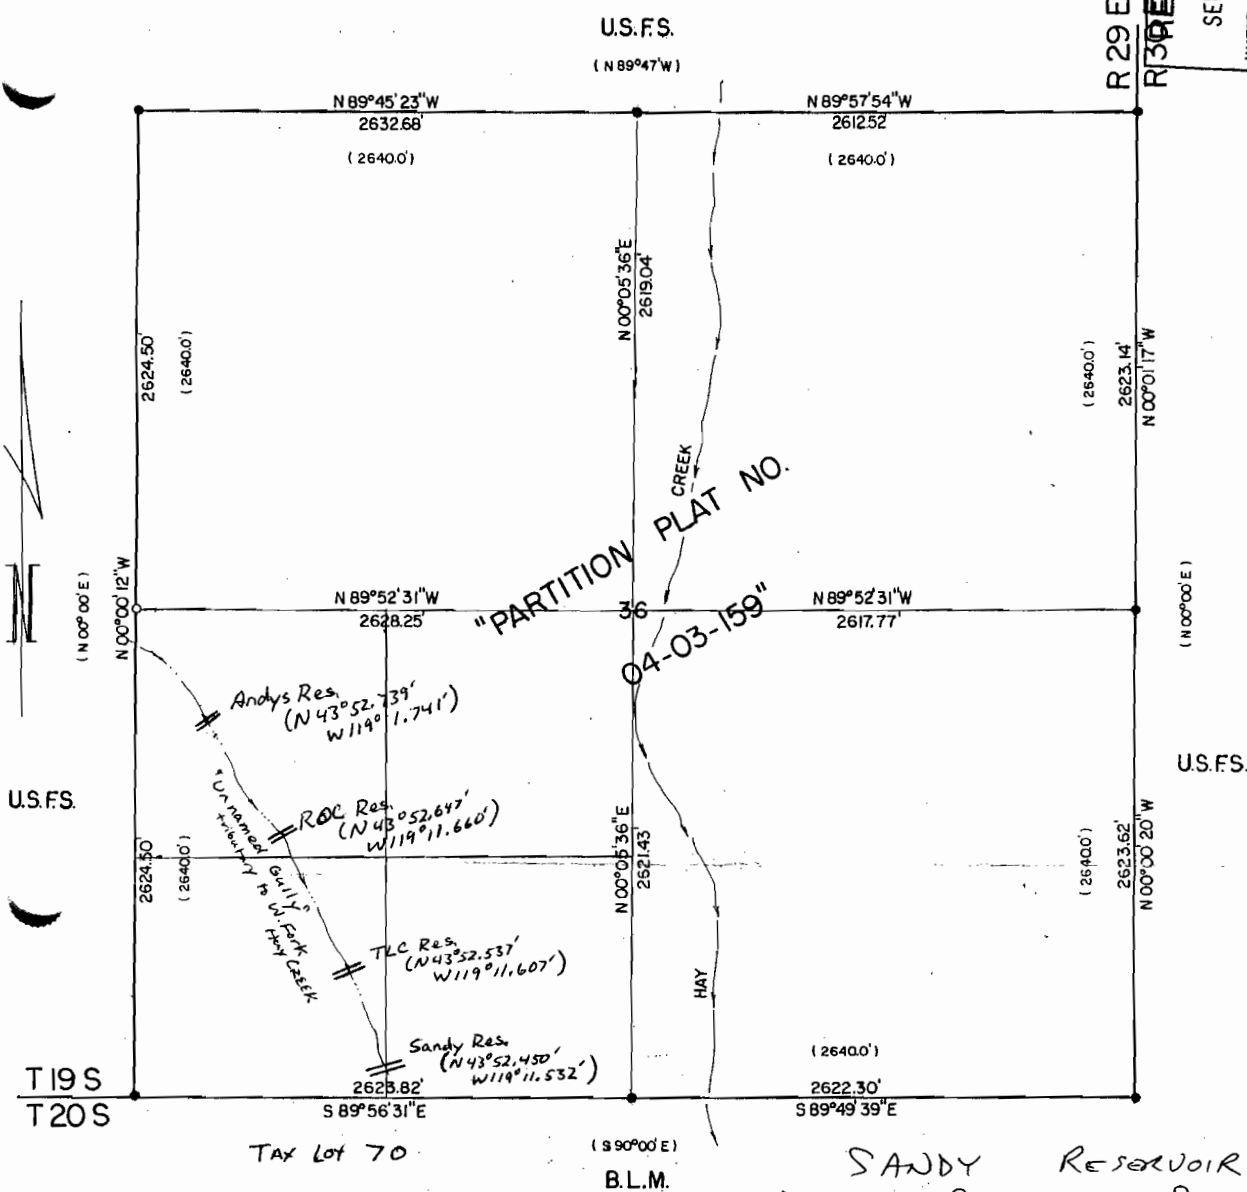

NARRATIVE

1. This property boundary survey was done at the request of Scott Campbell.
2. Bearings are based on solar observations.
3. Previous survey of record - The G.L.O. survey done by James P. Currin & William H. Odell under contract no. 348, dated January 1, 1880.
4. For further information see "Harney County Corner Restoration Records".

LEGEND

- 1880 G.L.O. corners found and monumented with 3-1/4" alum. caps.
- 1880 G.L.O. corner not found. Set a 3-1/4" alum. cap at the proportioned location.
- () 1880 G.L.O. data of record.

SANDY RESERVOIR
LOCATED FROM CENTER SECT 36
2430 FE SOUTH
1325 FE WEST

RECORDED AS HARNEY,
COUNTY SURVEY NO. 928
Date: 06-02-2004
By: Chris Palmer H.O.G.

REGISTERED PROFESSIONAL LAND SURVEYOR OREGON SEPTEMBER 23, 1977 CHRIS T. PALMER 1288 RENEW 1-1-2005	SCOTT CAMPBELL		
	SURVEY PLAT		
Scale: 8" = 1 MILE Dsn: Dtn: CHRIS Ckd:	Date: JUNE 2004 M.A. PALMER & SONS, INC. ENGINEERING & SURVEYING 711 Ponderosa Village • Box 61 Burns, Oregon 97720	Job: 2174 Sht. No.: of 1	

2pp no R 86424
en 20
Permit no R
142-71