


SEC. 6 T.24S. R. 4W W.M.
DOUGLAS COUNTY

Scale: 1" = 1000'

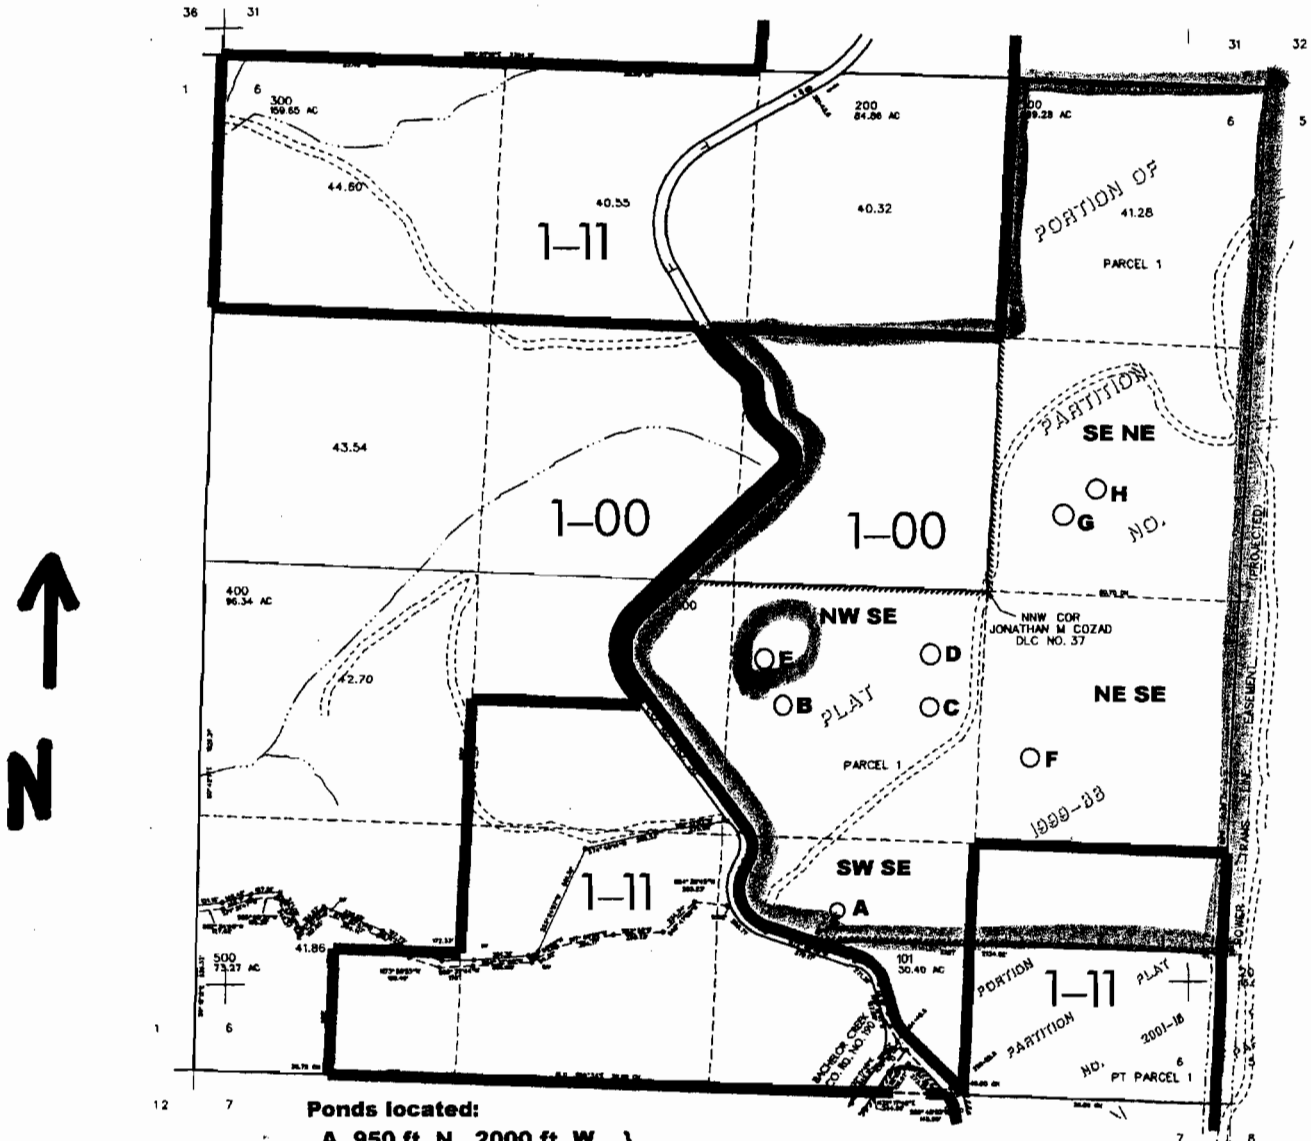

Ponds located:

- A 950 ft. N. 2000 ft. W. }
- B 2050 ft. N. 2350 ft. W. }
- C 2000 ft. N. 1550 ft. W. }
- D 2250 ft. N. 1550 ft. W. } All from the SE corner of Sec. 6
- E 2300 ft. N. 2450 ft. W. }
- F 1750 ft. N. 1050 ft. W. }
- G 3000 ft. N. 950 ft. W. }
- H 3200 ft. N. 750 ft. W. }

App# R-85533
Permit # R-13682

RECEIVED

APR 07 2003

WATER RESOURCES DEPT.
SALEM, OREGON