


T.6S.R.1W.W.M.

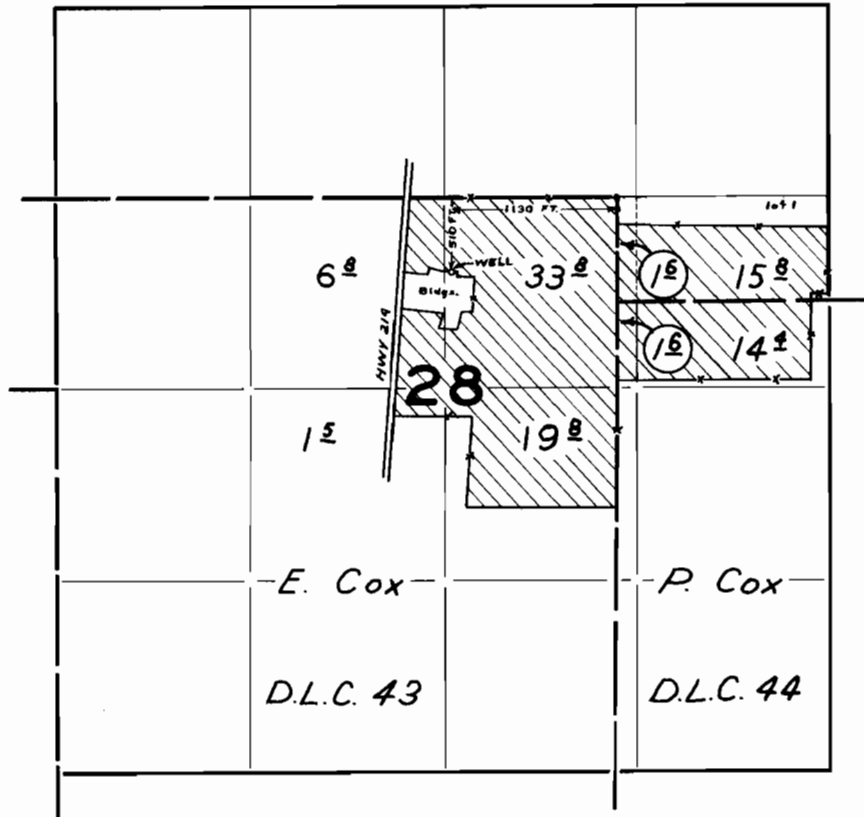

FINAL PROOF SURVEY UNDER

Application No. G-2246 Permit No. G-2068
IN NAME OF

ANTHONY SCHULTZ

Surveyed JUN 3 1965, by L. COLEBANK