


T. 15., R. 3W., W. M.

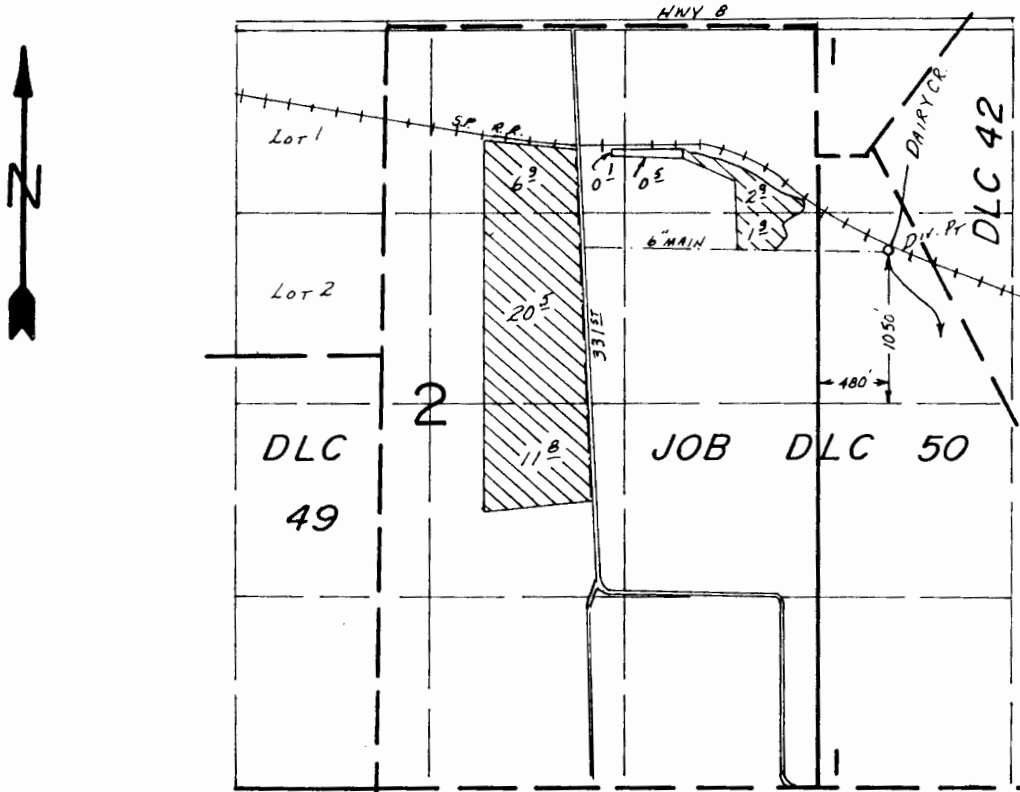

SCALE: 1"=1320'

**FINAL PROOF SURVEY**  
UNDER

TRANSFER No. 4308

IN NAME OF

.....EDMUND DUYCK.....

Surveyed Aug. 23, 19.84, by B.W. BISHOP.....

From file:  
App' 245/Permit 5-14030 / 49086  
#5877

Handwritten signature in a box: EDMUND DUYCK