


T. 10 S., R. 32 E., W.M.

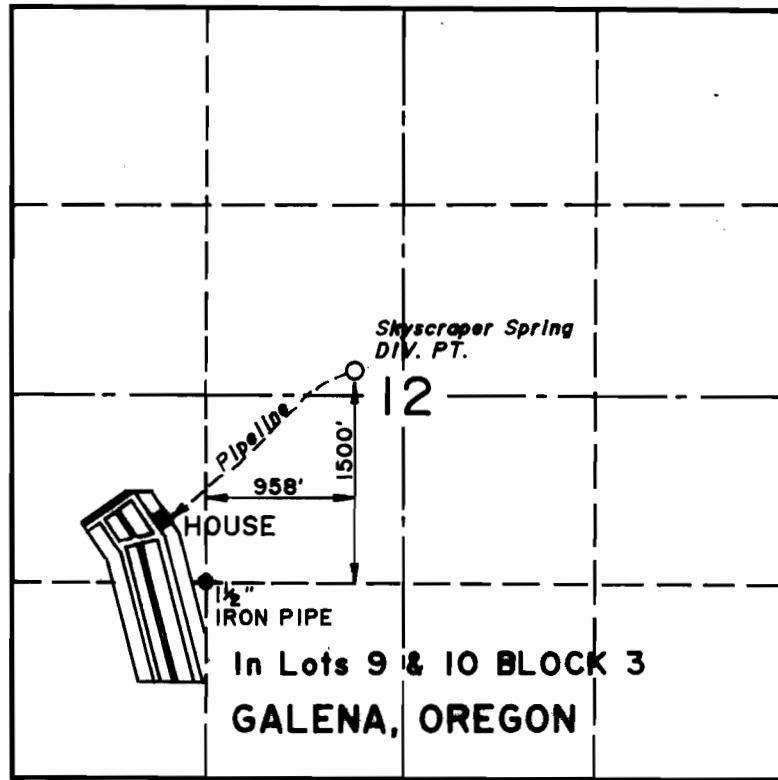

SCALE 1" = 1320'

The purpose of this map is for identifying the location of the water right only and is not intended to provide legal dimensions of property ownership lines.

FINAL PROOF SURVEY

Application No. 69718 Permit No. 51455

IN NAME OF

FLOYD AND MARGARET McCONNELL

Surveyed JULY 11, 1993

