


T. 14 S., R. 32 E., W.M.


RECEIVED

JUL - 1 1993

WATER RESOURCES DEPT.  
SALEM, OREGON

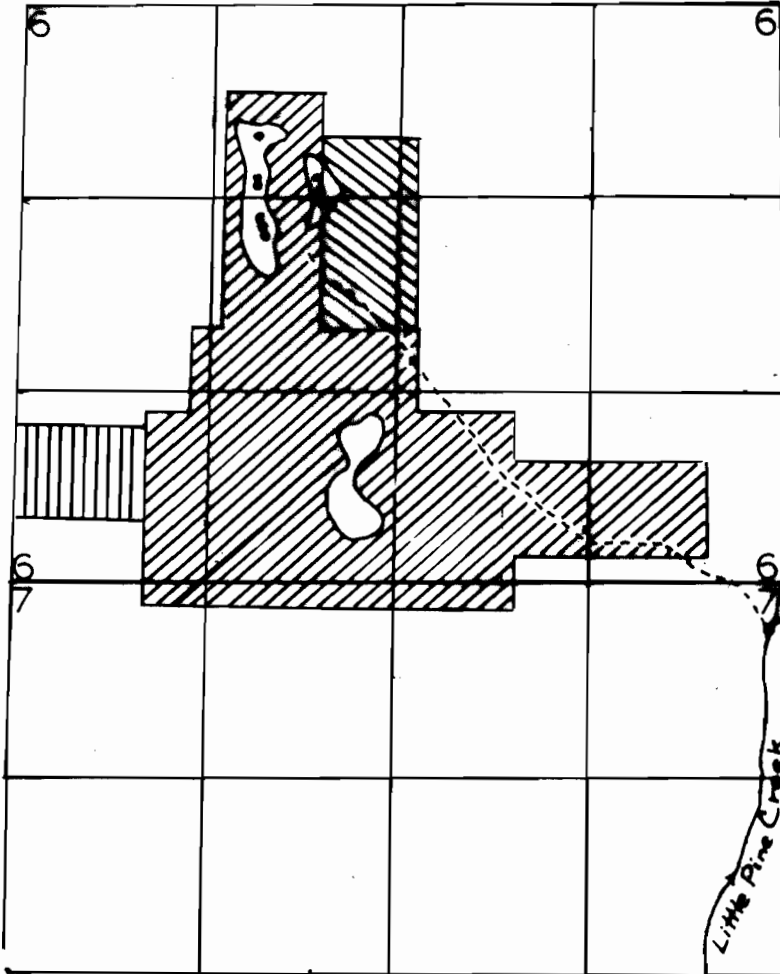

SW 1/4 SECTION 9

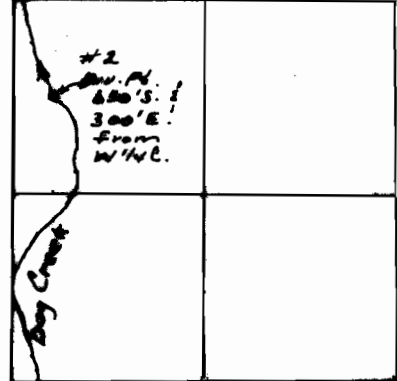

#1 Div. Pt. 330'S. & 100'W. from N.E. Corner.



P# 37897 BOUNDARY



P 41242 BOUNDARY



P 45910 BOUNDARY



WORKED AREAS

### FINAL PROOF SURVEY

UNDER

Application No. <b>61359</b>	Permit No. <b>45910</b>
54950	41242
50207	37897

IN NAME OF

**IMMANUEL MINING**

Surveyed 8-27, 1990, by K. KEMP



1" = 1320'