

T.13 S., R. 34 E., W.M.

APPLICATION MAP FOR

DELMAS & SHERYL


RAYMOND

Inspection Survey Map.

**RECEIVED**

SEP 14 1983

WATER RESOURCES DEPT.  
SALEM, OR

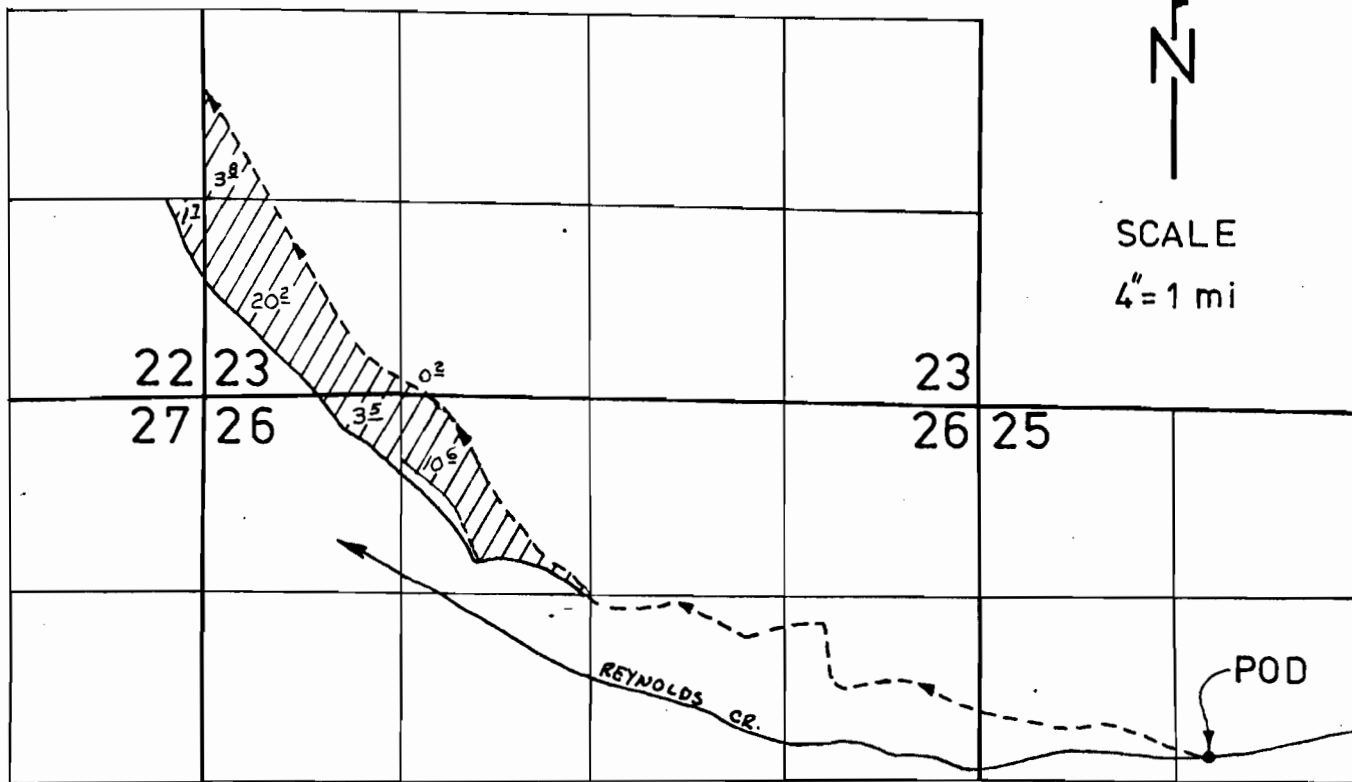

PUD is located 2400 ft S & 1550 ft E of NW corner Sec.25 approved

Map based on John Day River Adjudication map 121-2-3

THIS MAP PREPARED BY:  
*[Signature]* 8-15-83  
FROM INFORMATION FURNISHED BY  
THE APPLICANT

**Application No. 66050**  
**Permit No. 48051**