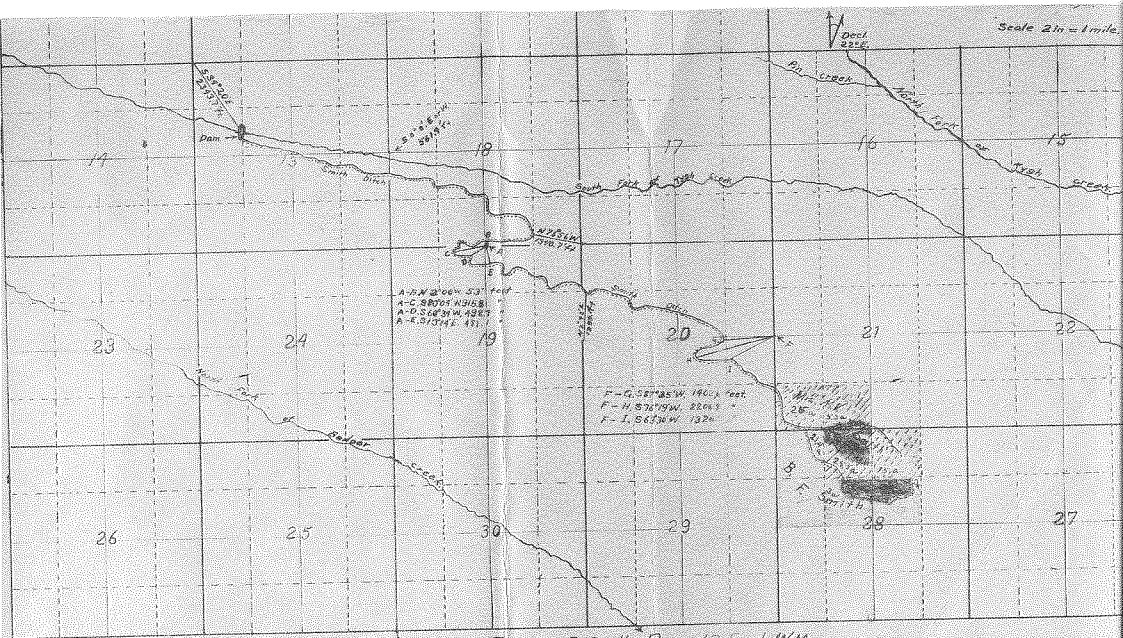

Township 3 South, Range 11 East, W.M.

Township 3 South, Range 12 East, W.M.

Legend

Irrigated Land in Cultivation.

Irrigated Pasture Land.

Land not Irrigated at Present.

P. 1872

Continued 1875?