


T.15 S., R. 25 E., W.M.

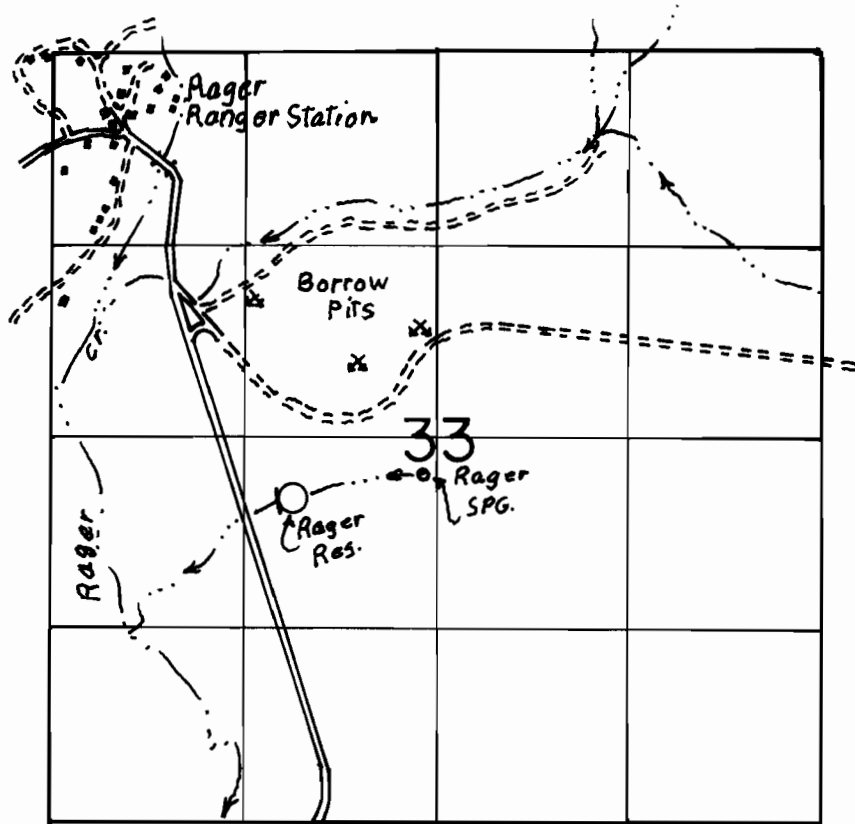

RES. LOC: 2200' N & 1650' E FROM SW COR. OF SEC 33.

SCALE: 1" = 1320'

FINAL PROOF SURVEY
UNDER

Application No. R-66332 Permit No. R-11391.....
IN NAME OF

UNITED STATES, OCHOCO NAT. FOREST

Surveyed JULY 26 19 95, by R.M. SUTTERFIELD