


T. 19 S., R. 26 E., W.M.

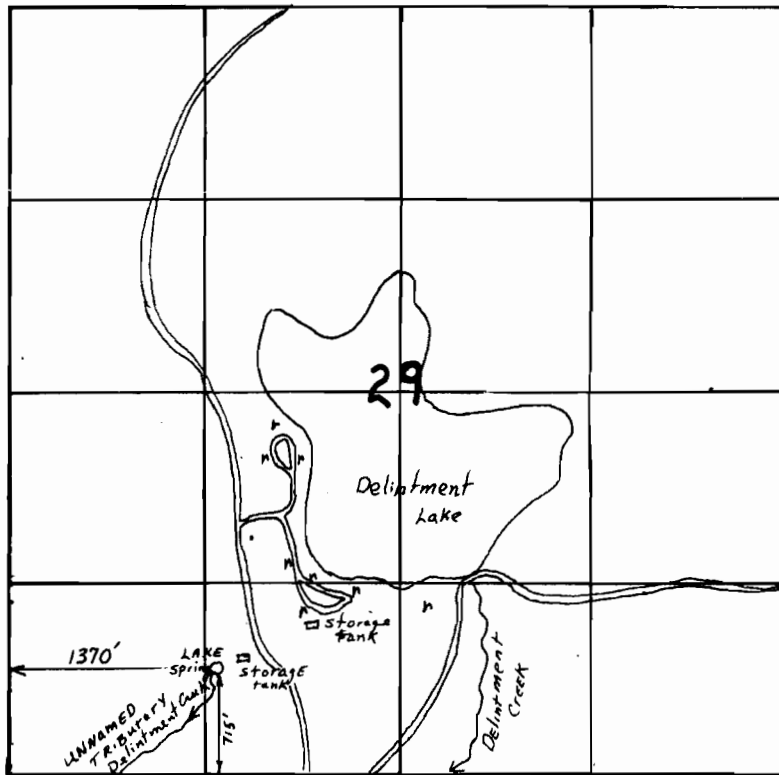

SCALE - 4" = 1 MILE

RECEIVED

JUN 8 1983

WATER RESOURCES DEPT.

SALEM, OREGON

n-spigots

RECEIVED

MAY 5 1983

WATER RESOURCES DEPT.
SALEM, OREGON

Application No. 60866

Permit No. 48519