


T.20S., R. 27E., W.M.

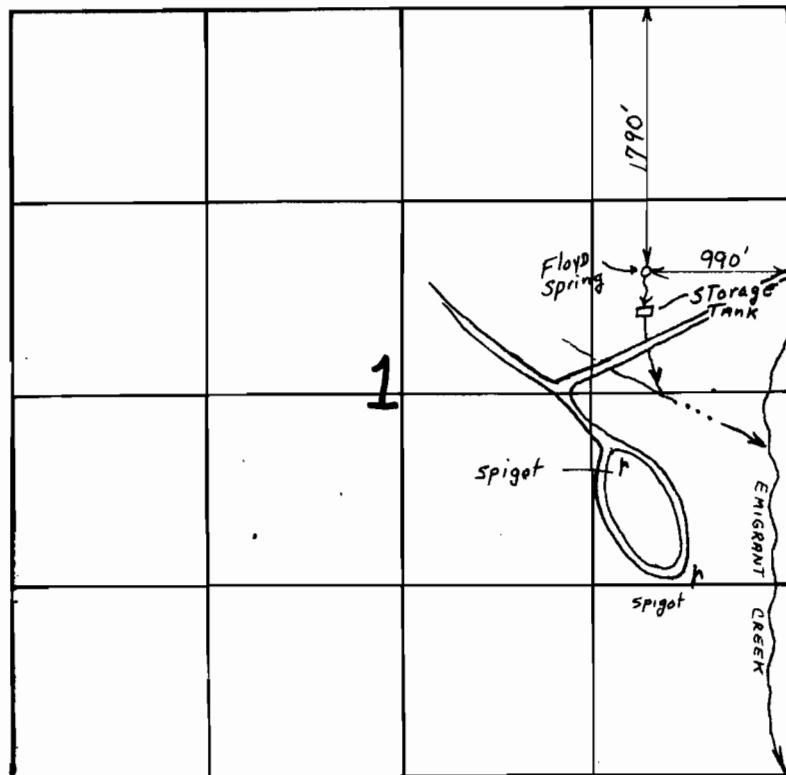

SCALE - 4" = 1 MILE

Application No. 60867

Permit No. 48520

RECEIVED
MAY 8 1983
WATER RESOURCES DEPT.
SALEM, OREGON