


T. 19 S., R. 26 E., W. M.

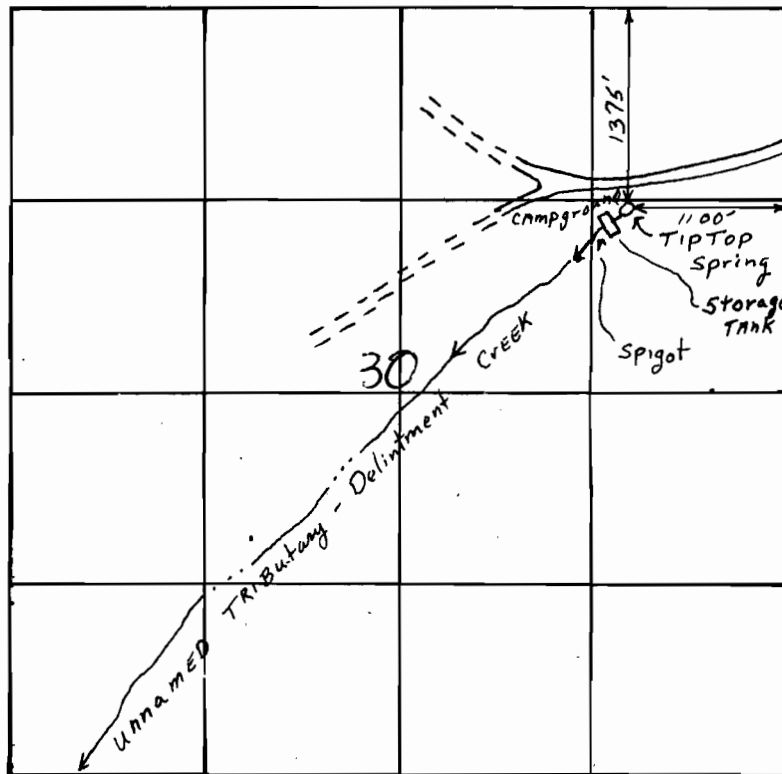

SCALE - 4" = 1 MILE

Application No. 60000
Permit No. 48521

RECEIVED
MAY 6 1983
WATER RESOURCES DEPT.
SALEM, OREGON